

GIS REGISTRY

Cover Sheet

July, 2008
(RR 5367)

Source Property Information

BRRTS #:

ACTIVITY NAME:

PROPERTY ADDRESS:

MUNICIPALITY:

PARCEL ID #:

CLOSURE DATE:

FID #:

DATCP #:

COMM #:

*WTM COORDINATES:

X: Y:

** Coordinates are in
WTM83, NAD83 (1991)*

WTM COORDINATES REPRESENT:

Approximate Center Of Contaminant Source

Approximate Source Parcel Center

Please check as appropriate: (BRRTS Action Code)

Contaminated Media:

Groundwater Contamination > ES (236)

Contamination in ROW

Off-Source Contamination

*(note: for list of off-source properties
see "Impacted Off-Source Property")*

Soil Contamination > *RCL or **SSRCL (232)

Contamination in ROW

Off-Source Contamination

*(note: for list of off-source properties
see "Impacted Off-Source Property")*

Land Use Controls:

Soil: maintain industrial zoning (220)

*(note: soil contamination concentrations
between residential and industrial levels)*

Structural Impediment (224)

Site Specific Condition (228)

Cover or Barrier (222)

*(note: maintenance plan for
groundwater or direct contact)*

Vapor Mitigation (226)

Maintain Liability Exemption (230)

*(note: local government or economic
development corporation)*

Monitoring wells properly abandoned? (234)

Yes No N/A

** Residual Contaminant Level*

***Site Specific Residual Contaminant Level*

This Adobe Fillable form is intended to provide a list of information that is required for evaluation for case closure. It is to be used in conjunction with Form 4400-202, Case Closure Request. The closure of a case means that the Department has determined that no further response is required at that time based on the information that has been submitted to the Department.

NOTICE: Completion of this form is mandatory for applications for case closure pursuant to ch. 292, Wis. Stats. and ch. NR 726, Wis. Adm. Code, including cases closed under ch. NR 746 and ch. NR 726. The Department will not consider, or act upon your application, unless all applicable sections are completed on this form and the closure fee and any other applicable fees, required under ch. NR 749, Wis. Adm. Code, Table 1 are included. It is not the Department's intention to use any personally identifiable information from this form for any purpose other than reviewing closure requests and determining the need for additional response action. The Department may provide this information to requesters as required by Wisconsin's Open Records law [ss. 19.31 - 19.39, Wis. Stats.].

BRRTS #: 02-07-546801 PARCEL ID #: 32-5328-04-800

ACTIVITY NAME: DANBURY GENERATING FACILITY - AOC #1 WTM COORDINATES: X: 336398 Y: 617056

CLOSURE DOCUMENTS (the Department adds these items to the final GIS packet for posting on the Registry)

- Closure Letter**
- Maintenance Plan** (if activity is closed with a land use limitation or condition (land use control) under s. 292.12, Wis. Stats.)
- Conditional Closure Letter**
- Certificate of Completion (COC)** for VPLE sites

SOURCE LEGAL DOCUMENTS

- Deed:** The most recent deed as well as legal descriptions, for the **Source Property** (where the contamination originated). Deeds for other, off-source (off-site) properties are located in the **Notification** section.
Note: If a property has been purchased with a land contract and the purchaser has not yet received a deed, a copy of the land contract which includes the legal description shall be submitted instead of the most recent deed. If the property has been inherited, written documentation of the property transfer should be submitted along with the most recent deed.
- Certified Survey Map:** A copy of the certified survey map or the relevant section of the recorded plat map for those properties where the legal description in the most recent deed refers to a certified survey map or a recorded plat map. (lots on subdivided or platted property (e.g. lot 2 of xyz subdivision)).
Figure #: 1 Title: Property Ownership Map
- Signed Statement:** A statement signed by the Responsible Party (RP), which states that he or she believes that the attached legal description accurately describes the correct contaminated property.

MAPS (meeting the visual aid requirements of s. NR 716.15(2)(h))

Maps must be no larger than 8.5 x 14 inches unless the map is submitted electronically.

- Location Map:** A map outlining all properties within the contaminated site boundaries on a U.S.G.S. topographic map or plat map in sufficient detail to permit easy location of all parcels. If groundwater standards are exceeded, include the location of all potable wells within 1200 feet of the site.
Note: Due to security reasons municipal wells are not identified on GIS Packet maps. However, the locations of these municipal wells must be identified on Case Closure Request maps.
Figure #: 2 Title: Location Map
- Detailed Site Map:** A map that shows all relevant features (buildings, roads, individual property boundaries, contaminant sources, utility lines, monitoring wells and potable wells) within the contaminated area. This map is to show the location of all contaminated public streets, and highway and railroad rights-of-way in relation to the source property and in relation to the boundaries of groundwater contamination exceeding a ch. NR 140 Enforcement Standard (ES), and/or in relation to the boundaries of soil contamination exceeding a Residual Contaminant Level (RCL) or a Site Specific Residual Contaminant Levels (SSRCL) as determined under s. NR 720.09, 720.11 and 720.19.
Figure #: 3 Title: Detailed Site Map & 1a property Lines & Physical Features
- Soil Contamination Contour Map:** For sites closing with residual soil contamination, this map is to show the location of all contaminated soil and a single contour showing the horizontal extent of each area of contiguous residual soil contamination that exceeds a Residual Contaminant Level (RCL) or a Site Specific Residual Contaminant Level (SSRCL) as determined under s. NR 720.09, 720.11 and 720.19.
Figure #: 4 Title: Soil Contamination Details AOC#1

BRRTS #: 02-07-546801

ACTIVITY NAME: DANBURY GENERATING FACILITY - AOC #1

MAPS (continued)

- Geologic Cross-Section Map:** A map showing the source location and vertical extent of residual soil contamination exceeding a Residual Contaminant Level (RCL) or a Site Specific Residual Contaminant Level (SSRCL). If groundwater contamination exceeds a ch. NR 140 Enforcement Standard (ES) when closure is requested, show the source location and vertical extent, water table and piezometric elevations, and locations and elevations of geologic units, bedrock and confining units, if any.

Figure #: 5 **Title: Geologic Cross Section A - A'**

Figure #: 6 **Title: Geologic Cross Section B - B'**

- Groundwater Isoconcentration Map:** For sites closing with residual groundwater contamination, this map shows the horizontal extent of all groundwater contamination exceeding a ch. NR140 Preventive Action Limit (PAL) and an Enforcement Standard (ES). Indicate the direction and date of groundwater flow, based on the most recent sampling data.

Note: This is intended to show the total area of contaminated groundwater.

Figure #: 7 **Title: Groundwater Contamination Details AOC#1**

- Groundwater Flow Direction Map:** A map that represents groundwater movement at the site. If the flow direction varies by more than 20° over the history of the site, submit 2 groundwater flow maps showing the maximum variation in flow direction.

Figure #: 8 **Title: Groundwater Contours - 11/00**

Figure #: 9 **Title: Groundwater Contours - 10/07**

TABLES (meeting the requirements of s. NR 716.15(2)(h)(3))

Tables must be no larger than 8.5 x 14 inches unless the table is submitted electronically. Tables must not contain shading and/or cross-hatching. The use of **BOLD** or *ITALICS* is acceptable.

- Soil Analytical Table:** A table showing remaining soil contamination with analytical results and collection dates.
Note: This is one table of results for the contaminants of concern. Contaminants of concern are those that were found during the site investigation, that remain after remediation. It may be necessary to create a new table to meet this requirement.

Table #: 1 **Title: Soil Analytical Results**

- Groundwater Analytical Table:** Table(s) that show the most recent analytical results and collection dates, for all monitoring wells and any potable wells for which samples have been collected.

Table #: 2 **Title: Groundwater Analytical Results**

- Water Level Elevations:** Table(s) that show the previous four (at minimum) water level elevation measurements/dates from all monitoring wells. If present, free product is to be noted on the table.

Table #: 3 **Title: Water Table Elevations**

IMPROPERLY ABANDONED MONITORING WELLS

For each monitoring well not properly abandoned according to requirements of s. NR 141.25 include the following documents.

Note: If the site is being listed on the GIS Registry for only an improperly abandoned monitoring well you will only need to submit the documents in this section for the GIS Registry Packet.

- Not Applicable**

- Site Location Map:** A map showing all surveyed monitoring wells with specific identification of the monitoring wells which have not been properly abandoned.

Note: If the applicable monitoring wells are distinctly identified on the Detailed Site Map this Site Location Map is not needed.

Figure #: **Title:**

- Well Construction Report:** Form 4440-113A for the applicable monitoring wells.

- Deed:** The most recent deed as well as legal descriptions for each property where a monitoring well was not properly abandoned.

- Notification Letter:** Copy of the notification letter to the affected property owner(s).

BRRTS #: 02-07-546801

ACTIVITY NAME: DANBURY GENERATING FACILITY - AOC #1

NOTIFICATIONS

Source Property

- Letter To Current Source Property Owner:** If the source property is owned by someone other than the person who is applying for case closure, include a copy of the letter notifying the current owner of the source property that case closure has been requested.
- Return Receipt/Signature Confirmation:** Written proof of date on which confirmation was received for notifying current source property owner.

Off-Source Property

Group the following information per individual property and label each group according to alphabetic listing on the "Impacted Off-Source Property" attachment.

- Letter To "Off-Source" Property Owners:** Copies of all letters sent by the Responsible Party (RP) to owners of properties with groundwater exceeding an Enforcement Standard (ES), and to owners of properties that will be affected by a land use control under s. 292.12, Wis. Stats.
- Note:** Letters sent to off-source properties regarding residual contamination must contain standard provisions in Appendix A of ch. NR 726.

Number of "Off-Source" Letters:

- Return Receipt/Signature Confirmation:** Written proof of date on which confirmation was received for notifying any off-source property owner.
- Deed of "Off-Source" Property:** The most recent deed(s) as well as legal descriptions, for all affected deeded **off-source property(ies)**. This does not apply to right-of-ways.
- Note:** If a property has been purchased with a land contract and the purchaser has not yet received a deed, a copy of the land contract which includes the legal description shall be submitted instead of the most recent deed. If the property has been inherited, written documentation of the property transfer should be submitted along with the most recent deed.
- Letter To "Governmental Unit/Right-Of-Way" Owners:** Copies of all letters sent by the Responsible Party (RP) to a city, village, municipality, state agency or any other entity responsible for maintenance of a public street, highway, or railroad right-of-way, within or partially within the contaminated area, for contamination exceeding a groundwater Enforcement Standard (ES) and/or soil exceeding a Residual Contaminant Level (RCL) or a Site Specific Residual Contaminant Level (SSRCL).

Number of "Governmental Unit/Right-Of-Way Owner" Letters:



State of Wisconsin \ DEPARTMENT OF NATURAL RESOURCES

Jim Doyle, Governor
Matthew J. Frank, Secretary
John Gozdziwski, Regional Director

Park Falls Service Center
875 S. 4th Ave
Park Falls, Wisconsin 54552
Telephone 715-762-4684
FAX 715-762-4348

June 28, 2010

Mr. John Dahlberg
NVEC
104 S. Pine Street
Grantsburg, Wisconsin 54840

SUBJECT: Final Case Closure with Continuing Obligations
Danbury Generating Facility, Area of Concern #1/Turbine Generating Facility,
Danbury, Wisconsin, WDNR BRRTS Activity #: 02-07-546801

Dear Mr. Dahlberg:

On February 2, 2010, the Northern Region Closure Committee reviewed the above referenced case for closure. This committee reviews environmental remediation cases for compliance with state laws and standards to maintain consistency in the closure of these cases. On February 10, 2010, you were notified that the Closure Committee had granted conditional closure to this case.

On June 10, 2010, the Department received information or documentation of abandonment of the on-site monitoring wells and groundwater disposal.

Based on the correspondence and data provided, it appears that your case meets the closure requirements in ch. NR 726, Wisconsin Administrative Code. The Department considers this case closed and no further investigation or remediation is required at this time, however, you and future property owners must comply with certain continuing obligations as explained in this letter.

GIS Registry

This site will be listed on the Remediation and Redevelopment Program's GIS Registry. The specific reasons are summarized below:

- Residual soil contamination exists that must be properly managed should it be excavated or removed
- If a structural impediment that obstructed a complete site investigation or cleanup is removed or modified, additional environmental work must be completed
- Groundwater contamination is present above Chapter NR 140 enforcement standards

This letter and information that was submitted with your closure request application will be included on the GIS Registry. To review the sites on the GIS Registry web page, visit the RR Sites Map page at <http://dnr.wi.gov/org/aw/rr/gis/index.htm>. If the property is listed on the GIS Registry because of remaining contamination and you intend to construct or reconstruct a well, you will need prior Department approval in accordance with s. NR 812.09(4)(w), Wis. Adm. Code. To obtain approval, Form 3300-254 needs to be completed and submitted to the DNR

Drinking and Groundwater program's regional water supply specialist. This form can be obtained on-line <http://dnr.wi.gov/org/water/dwg/3300254.pdf> or at the web address listed above for the GIS Registry.

Closure Conditions

Please be aware that pursuant to s. 292.12 Wisconsin Statutes, compliance with the requirements of this letter is a responsibility to which you and any subsequent property owners must adhere. You must pass on the information about these continuing obligations to the next property owner or owners. If these requirements are not followed or if additional information regarding site conditions indicates that contamination on or from the site poses a threat to public health, safety, welfare, or the environment, the Department may take enforcement action under s. 292.11 Wisconsin Statutes to ensure compliance with the specified requirements, limitations or other conditions related to the property or this case may be reopened pursuant to s. NR 726.09, Wis. Adm. Code. The Department intends to conduct inspections in the future to ensure that the conditions included in this letter are met.

Residual Soil Contamination

Residual soil contamination remains as indicated on Figure 4, AOC #1 Soil Contaminant Details, prepared by SEH, dated November 5, 2009, a copy of which is attached. If soil in the specific locations described above is excavated in the future, then pursuant to ch. NR 718 or, if applicable, ch. 289, Stats., and chs. 500 to 536, the property owner at the time of excavation must sample and analyze the excavated soil to determine if residual contamination remains. If sampling confirms that contamination is present the property owner at the time of excavation will need to determine whether the material is considered solid or hazardous waste and ensure that any storage, treatment or disposal is in compliance with applicable standards and rules. In addition, all current and future owners and occupants of the property need to be aware that excavation of the contaminated soil may pose an inhalation or other direct contact hazard and as a result special precautions may need to be taken to prevent a direct contact health threat to humans.

Structural Impediments

Structural impediments existing at the time of cleanup as shown on Figure 4, the AST containment structure, made complete investigation of the soil contamination on this property impracticable. Pursuant to s. 292.12(2)(b), Wis. Stats., if the structural impediment on this property that is described above is to be removed, the property owner shall notify the Department of Natural Resources before removal and conduct an investigation of the degree and extent of petroleum contamination. If contamination is found at that time, the contamination shall be properly remediated in accordance with applicable statutes and rules. If soil in the specific locations described above is excavated, the property owner at the time of excavation must sample and analyze the excavated soil to determine if residual contamination remains. If sampling confirms that contamination is present the property owner at the time of excavation will need to determine whether the material is considered solid or hazardous waste and ensure that any storage, treatment or disposal is in compliance with applicable statutes and rules. In addition, all current and future owners and occupants of the property need to be aware that excavation of the contaminated soil may pose an inhalation or other direct contact hazard and as a result special precautions may need to be taken during excavation activities to prevent a health threat to humans.

Residual Groundwater Contamination

Groundwater impacted by petroleum contamination greater than enforcement standards set forth in ch. NR140, Wis. Adm. Code, is present on this contaminated property as identified on Figure 7, AOC #1 Groundwater Contaminant Details, prepared by SEH, dated November 5, 2009, a copy of which is attached. For more detailed information regarding the locations where groundwater samples have been collected (i.e., monitoring well locations) and the associated contaminant concentrations, refer to the Remediation and Redevelopment Program's GIS Registry at the RR Sites Map page at <http://dnr.wi.gov/org/aw/rr/gis/index.htm>.

Dewatering Permits

The Department's Watershed Management Program regulates point source discharges of contaminated water, including discharges to surface waters, storm sewers, pits or to the ground surface. This includes discharges from construction related dewatering activities, including utility and building construction.

Based on the concentrations of contaminants remaining in groundwater at this location, it appears likely that dewatering activities would require a permit from the Watershed Management Program. If you or any other person plan to conduct such activities, you or that person must contact that program, and if necessary, apply for the necessary discharge permit. Additional information regarding discharge permits is available at <http://www.dnr.state.wi.us/org/water/wm/ww/>

Post-Closure Notification Requirements


In accordance with ss, 292.12 and 292.13, Wis. Stats., you must notify the Department before making changes that affect or relate to the conditions of closure in this letter. For this case, examples of changed conditions requiring prior notification include, but are not limited to:

- Any activity or construction that results in the removal or modification of a structural impediment that obstructed a complete site investigation or cleanup

Please send written notifications in accordance with the above requirements to the Department's Park Falls Office, to the attention of Phil Richard.


The Department appreciates your efforts to restore the environment at this site. If you have any questions regarding this closure decision or anything outlined in this letter, please contact Phil Richard at 715-762-1352.

Sincerely,

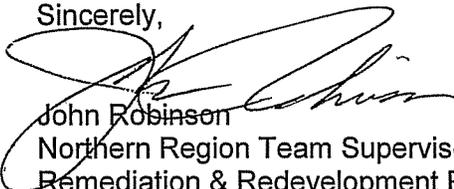
John Robinson
Northern Region Team Supervisor
Remediation & Redevelopment Program

Attachments: Figure 4: AOC #1 Soil Contamination Details
Figure 7: AOC #1 Groundwater Contamination Details

C: Darrell Reed, SEH 421 Frenette Drive, Chippewa Falls, WI 54729
File

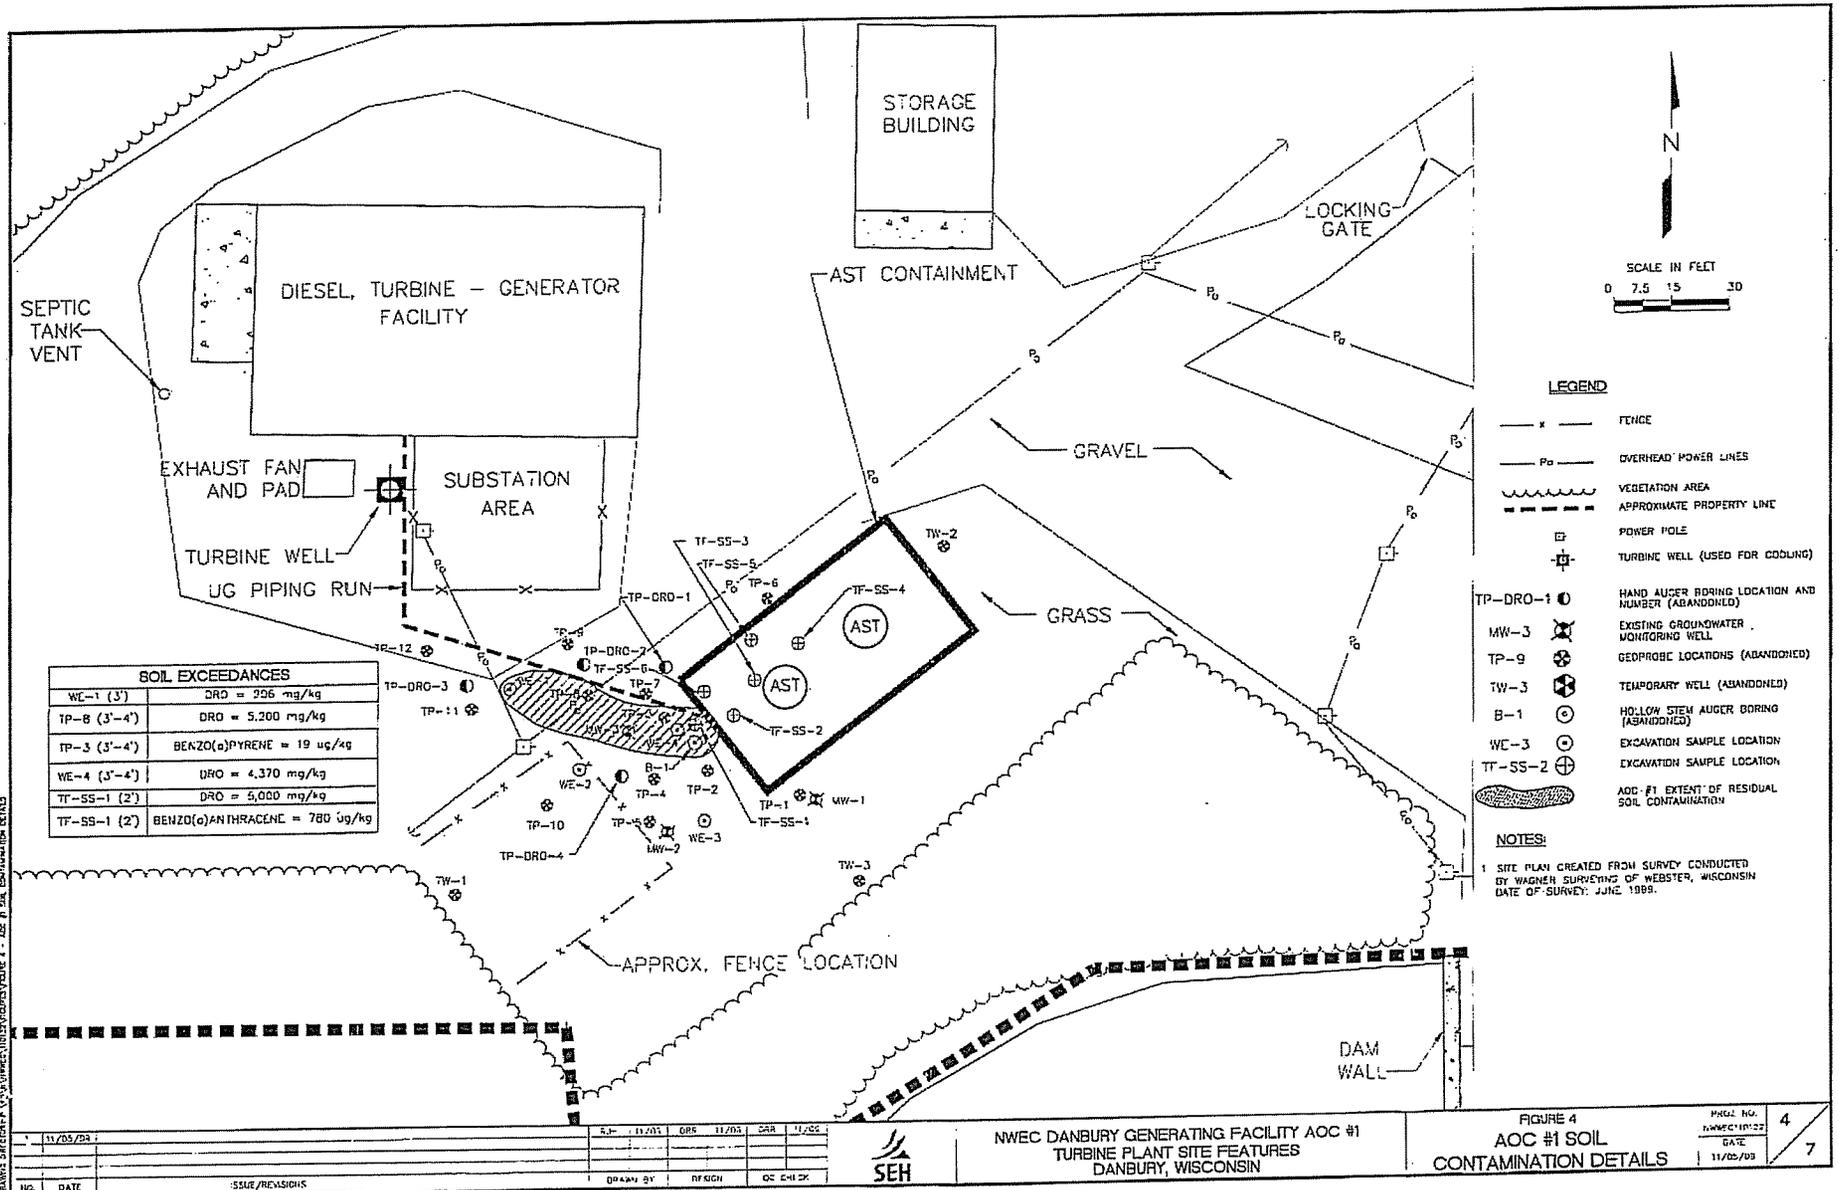


SOIL EXCEEDANCES	
WE-1 (3')	DRO = 296 mg/kg
TP-8 (3'-4')	DRO = 5,200 mg/kg
TP-3 (3'-4')	BENZO(a)PYRENE = 19 ug/kg
WE-4 (3'-4')	DRO = 4,370 mg/kg
TF-SS-1 (2')	DRO = 5,000 mg/kg
TF-SS-1 (2')	BENZO(a)ANTHRACENE = 780 ug/kg

- LEGEND**
- x — FENCE
 - Pa — OVERHEAD POWER LINES
 - ~~~~~ VEGETATION AREA
 - - - - - APPROXIMATE PROPERTY LINE
 - ⊠ POWER POLE
 - ⊠ TURBINE WELL (USED FOR COOLING)
 - TP-DRO-1 ⊕ HAND AUGER BORING LOCATION AND NUMBER (ABANDONED)
 - MW-3 ⊗ EXISTING GROUNDWATER MONITORING WELL
 - TP-9 ⊕ GEOPROBE LOCATIONS (ABANDONED)
 - TW-3 ⊗ TEMPORARY WELL (ABANDONED)
 - B-1 ⊙ HOLLOW STEM AUGER BORING (ABANDONED)
 - WE-3 ⊙ EXCAVATION SAMPLE LOCATION
 - TF-SS-2 ⊕ EXCAVATION SAMPLE LOCATION
 - ⊕ ADD 1' EXTENT OF RESIDUAL SOIL CONTAMINATION

NOTES:
 1. SITE PLAN CREATED FROM SURVEY CONDUCTED BY WAGNER SURVEYING OF WEBSTER, WISCONSIN DATE OF SURVEY: JUNE 1989.

11/05/2011	11/20/11	085	11/20/11	SAR	11/20/11
NO.	DATE	ISSUE/REVISIONS	DRAWN BY	REVISION	QC CHECK

Put on BRRTS
2/10/10
(84)

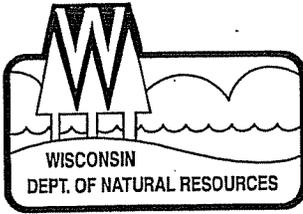

State of Wisconsin \ DEPARTMENT OF NATURAL RESOURCES

Jim Doyle, Governor
Matthew J. Frank, Secretary
John Gozdzialski, Regional Director

Park Falls Service Center
875 S. 4th Ave
Park Falls, Wisconsin 54552
Telephone 715-762-4684
FAX 715-762-4348

February 10, 2010

Mr. John Dahlberg
NVEC
104 S. Pine Street
Grantsburg, Wisconsin 54840

Subject: Conditional Closure Decision, With Requirements to Achieve Final Closure,
Danbury Generating Facility, AOC#1, 30150A First Ave, Danbury, Wisconsin,
WDNR BRRTS Activity # 02-07-546801

Dear Mr. Dahlberg:

On February 4, 2010, the Northern Region Closure Committee reviewed your request for closure of the case described above. The Northern Region Closure Committee reviews environmental remediation cases for compliance with state rules and statutes to maintain consistency in the closure of these cases. After careful review of the closure request, the Northern Region Closure Committee has determined that the petroleum contamination on the site from the former aboveground storage tank system appears to have been investigated and remediated to the extent practicable under site conditions. Your case has been remediated to Department standards in accordance with s. NR 726.05, Wis. Adm. Code and will be closed if the following conditions are satisfied:

Monitoring Well Abandonment

The monitoring wells at the site must be properly abandoned in compliance with ch. NR 141, Wis. Adm. Code. Documentation of well abandonment must be submitted to me on Form 3300-005 found at <http://dnr.wi.gov/org/water/dwg/gw/> or provided by the Department of Natural Resources.

Purge Water, Waste and Soil Pile Disposal


Any remaining purge water, waste and/or soil piles generated as part of site investigation or remediation activities must be removed from the site and disposed of or treated in accordance with Department of Natural Resources' rules. Once that work is completed, please send appropriate documentation regarding the treatment or disposal of the remaining purge water, waste and/or soil piles.

When the above conditions have been satisfied, please submit the appropriate documentation (for example, well abandonment forms, disposal receipts, copies of correspondence, etc.) to verify that applicable conditions have been met, and your case will be closed. Your site will be listed on the DNR Remediation and Redevelopment GIS Registry of Closed Remediation Sites. Information that was submitted with your closure request application will be included on the GIS Registry. To review the site on the GIS Registry web page, visit the RR Sites Map page at: <http://dnr.wi.gov/org/aw/rr/gis/index.htm>.

Please be aware that the case may be reopened pursuant to s. NR 726.09, Wis. Adm. Code, if additional information regarding site conditions indicates that contamination on or from the site poses a threat to public health, safety, or welfare or to the environment.

We appreciate your efforts to restore the environment at this site. If you have any questions regarding this letter, please contact me at 715-762-1352.

Sincerely,

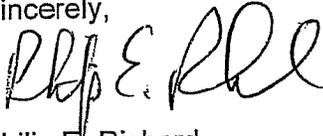A handwritten signature in black ink, appearing to read "P. E. Richard". The signature is written in a cursive style with some loops and flourishes.

Philip E. Richard
Hydrogeologist
Remediation and Redevelopment Program

Enclosure

C: Darrell Reed, SEH, 421 Frenette Drive, Chippewa Falls, WI 54729
File

V61 P16

Doc. #
111281

This Indenture, Made this 22nd day of July, A. D., 1943
between Frank N. Dahlberg and Lullette Dahlberg, his wife

parties of the first part, and

Northwestern Wisconsin Electric Company
a Corporation duly organized and existing under and by virtue of the laws of the State of Wisconsin,
located at Grantsburg, Wisconsin, party of the second part.

Witnesseth, That the said parties of the first part, for and in consideration of the sum of
One Dollar and other valuable considerations - - - - -

to them in hand paid by the said party of the second part, the receipt whereof is hereby confessed
and acknowledged, have given, granted, bargained, sold, remised, released, aliened, conveyed and con-
firmed, and by these presents do give, grant, bargain, sell, remise, release, alien, convey and confirm
unto the said party of the second part, its successors and assigns forever, the following described real
estate, situated in the County of Burnett and State of Wisconsin, to-wit:

The East Half of the Northwest Quarter of the Southeast Quarter (E $\frac{1}{2}$ NW $\frac{1}{4}$ SE $\frac{1}{4}$) of
Section Twenty-eight (28), Township Forty-one (41) North, of Range Sixteen (16) West,
except the right of way of the Minneapolis, St. Paul and Sault Ste Marie Railway
Company across said land, and except the right of way of the Wisconsin Telephone
Company across land, and further excepting a parcel of land across the North end of the
land herein conveyed 399 feet in width extending from the right of way of the Mpls.,
St. Paul and Sault Ste Marie Railway Company, on the East to the West line of the
land herein conveyed, which parcel comprises a part of Peet's First Addition to
Danbury.

Southwest Quarter of the Southeast Quarter (SW $\frac{1}{4}$ SE $\frac{1}{4}$) of Section Twenty-eight,
Township Forty-one (41) North of Range Sixteen (16) West.



Together with all and singular the hereditaments and appurtenances thereunto belonging or in anywise
appertaining; and all the estate, right, title, interest, claim or demand whatsoever, of the said part 1st of
the first part, either in law or equity, either in possession or expectancy of, in and to the above bargained prem-
ises, and their hereditaments and appurtenances.

To have and to hold the said premises as above described with the hereditaments and appurtenances,
unto the said party of the second part, and to its successors and assigns FOREVER.

And the said Frank N. Dahlberg and Lullette Dahlberg, his wife

for themselves and heirs, executors and administrators, do covenant, grant, bargain,
and agree to and with the said party of the second part, its successors and assigns, that at the time of the
ensealing and delivery of these presents they are well seized of the premises above described,
as of a good, sure, perfect, absolute and indefeasible estate of inheritance in the law, in fee simple, and
that the same are free and clear from all incumbrances whatever,

and that the above bargained premises in the quiet and peaceable possession of the said party of the
second part, its successors and assigns, against all and every person or persons lawfully claiming the
whole or any part thereof, they will forever WARRANT and DEFEND.

In Witness Whereof, the said parties of the first part have hereunto set their hands and
seals this 22nd day of July, A. D., 1943.

Signed and Sealed in Presence of

Dorcas E. Clementson

Billy Anderson

Frank N. Dahlberg (Seal)

Lullette Dahlberg (Seal)

(Seal)

(Seal)

NUMBER

This Indenture, Made this 21st day of November, A. D., 19 46,

118747

between Raymond H. Rixman and Joy B. Rixman, his wife

part 1es of the first part, and

Northwestern Wisconsin Electric Company

part 1es of the second part.

WITNESSETH, That the said part 1es of the first part, for and in consideration of the sum of

Two-hundred dollars (\$200.00)

to them in hand paid by the said part 1es of the second part, the receipt whereof is hereby confessed and acknowledged, ha ve given, granted, bargained, sold, remised, released, aliened, conveyed and confirmed, and by these presents do give, grant, bargain, sell, remise, release, alien, convey and confirm unto the said part 1es of the second part, heirs and assigns forever, the following described real estate, situated in the County of Burnett, and State of Wisconsin, to-wit:

All that part of the West Half of the Northwest Quarter of the Southeast Quarter (W 1/2 NW 1/4 SE 1/4) of Section Twenty-eight (28), Township Forty-one (41) North, of Range Sixteen (16) West, lying South of a line 699 feet South of the North line of said NW 1/4 SE 1/4, and East of the public highway as now laid out and travelled, excepting therefrom a parcel of land described as follows: Commencing at the Southwest corner of the NW 1/4 SE 1/4, 28-41-16, thence North 86° East for a distance of 132 feet to the centerline of highway, thence North 5° 47' West along the center line of said highway for 60 feet to a point for place of beginning, thence continuing North on the same line 261.5 feet, thence North 86° East 273 feet, thence South 4° East 261.4 feet, thence South 86 degrees West 264.9 feet to point of beginning.

Also including the following described parcel of land:

Beginning at the point of intersection of the South line of Peet Street and the West line of Block 13 of Peet's First Addition to Danbury, extended South, thence South 175.7 feet, thence East to the East line of the W 1/2 NW 1/4 SE 1/4, 28-41-16, thence South 124.3 feet, thence west to a point 300 feet South and 70 feet West of point of beginning, thence North 300 feet, thence East 70 feet to the point of beginning.

TOGETHER with all and singular the hereditaments and appurtenances thereunto belonging or in any wise appertaining; and all the estate, right, title, interest, claim or demand whatsoever, of the said part 1es of the first part, either in law or equity, either in possession or expectancy of, in and to the above bargained premises, and their hereditaments and appurtenances.

TO HAVE AND TO HOLD the said premises as above described with the hereditaments and appurtenances, unto the said part 1es of the second part, and to their heirs and assigns FOREVER.

AND THE SAID parties of the first part

for their heirs, executors and administrators, do covenant, grant, bargain and agree to and with the said part 1es of the second part, their heirs and assigns, that at the time of the enrolling and delivery of these presents well seized of the premises above described, as of a good, sure, perfect, absolute and indefeasible estate of inheritance in the law, in fee simple, and that the same are free and clear from all incumbrances whatever,

and that the above bargained premises in the quiet and peaceable possession of the said part 1es of the second part, their heirs and assigns, against all and every person or persons lawfully claiming the whole or any part thereof, they will forever WARRANT AND DEFEND.

IN WITNESS WHEREOF, the said part 1es of the first part have hereunto set their hand s and seal s this 21st day of November, A. D., 19 46.

Signed and Sealed in Presence of

Frank N. Dehlberg

Roy A. Blomberg

STATE OF WISCONSIN,

County, } ss.

Personally came before me, this 21st day of November, A. D., 19 46,

the above named Raymond H. Rixman and Joy B. Rixman, his wife

to me known to be the person s who executed the foregoing instrument and acknowledged the same.

Received for Record this 23 day of A.C.L. Peterson

Nov. A. D., 19 46, at 9 o'clock A. M. Notary Public, Burnett County, Wis.

Wilbur A. Thoreson Register of Deeds. My Commission expires Aug 28 A. D., 19 46



Burnett County, Wisconsin Property Report

The assessment database file contains ownership records within Burnett County. Ownership changes constantly. The requester acknowledges and accepts the limitations of the data, including the fact that the data is dynamic and is in a constant state of maintenance, correction and update.

CURRENT PROPERTY INFORMATION

PIN:	032-5328-04800
NEW PIN:	07-032-2-41-16-28-4 02-000-011000
Owner or Designee:	NORTHWESTERN WIS ELEC CO
Mailing Address:	P O BOX 9
Mailing City, State, Zip:	GRANTSBURG WI 54840
Site Address:	30161 S FIRST AVE
Municipality:	TOWN OF SWISS
PLS Location:	S28, T41, R16
History:	28-32 84/469
Document Number:	
Acres:	10.43 Acres
Legal Description:	PCL NW SE DESC 84/469 & 61/16 & 306/468 EX 572/553 & ALSO EX #337118
School District Code:	6293
School District Name:	SCHL-WEBSTER
Total Land Value:	\$0.00
Total Improved Value:	\$0.00
Total Value:	\$0.00

2008 TAX INFORMATION

Total Land Value:	\$0.00
Total Improvements:	\$0.00
Total Value:	\$0.00
Fair Market Ratio:	0
Fair Market Value:	\$0.00
Net Mill Rate:	.015989726
Net Tax:	\$0.00
Lottery Credit:	\$0.00
Special Assess, Chgs, Delq. Utilities:	\$0.00
Total Amount Due:	\$0.00
Total Payments:	\$0.00

Contact County Treasurer for current balance due.


[Print Listing](#)

[Print Map](#)

[Return To Selected Properties](#)

[Return To Search Methods](#)

I, John Dahlberg, assert to the best of my knowledge that the following legal description describes the property located at the Northwestern Wisconsin Electric Company (NVEC), Danbury Turbine Generating Facility, located at 30150A First Ave., Danbury, Burnett County, Wisconsin, which is applicable to the Wisconsin Department of Natural Resources Bureau of Remediation and Redevelopment Tracking System site number 02-07-546801. I also assert that no other properties in the vicinity, other than the one described below, are associated with the Northwestern Wisconsin Electric Company Danbury Turbine Generating Facility Property.

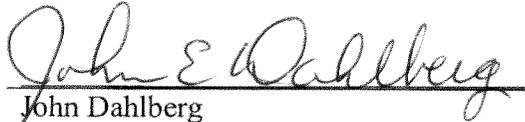
John Dahlberg
Secretary/Treasurer, NVEC

Date: June 2, 2009

Property Legal Description:

V84P469 – All that part of the West Half of the Northwest Quarter of the Southeast Quarter (W1/2, NW1/4, SE1/4) of Section Twenty-eight (28) Township Forty-one (41) North, of Range Sixteen (16) West, lying South of a line 699 feet South of the North line of said NW1/4 SE1/4, and East of the public highway as now laid out and travelled, excepting therefrom a parcel of land described as follows: Commencing at the Southwest corner of the NW1/4 SE1/4, 28-14-16, thence North 86degrees East for a distance of 132 feet to the centerline of highway, thence North 5 degrees 47 minutes West along the centerline of said highway for 60 feet to a point for place of beginning, thence continuing North on the same line 261.5 feet, thence North 86 degrees East 273 feet, thence South 4 degrees East 261.4 feet, thence South 86 degrees West 264.9 feet to point of beginning.


Also including the following described parcel of land:

Beginning at a point of intersection of the South line of Peet Street and the West line of Block 13 of Peet's First Addition to Danbury, extended South, then South 175.7 feet, thence East to the East line of the W1/2NW1/4, SE1/4, 28-41-16, thence South 124.3 feet, thence west to a point 300 feet South and 70 feet West of point of beginning, thence North 300 feet, thence East 70 feet to the point of beginning.

V61P16 - The East Half of the Northwest Quarter of the Southeast Quarter (E1/2 NW1/4 SE 1/4) of Section Twenty-eight (28), Township Forty-one (41) North, of Range Sixteen (16) West, except for the right of way of the Minneapolis St. Paul and Sault Ste Marie Railway Company across said land, further excepting a parcel of land across the North end of the land herein conveyed 399 feet in width extending from the right of way of the Mpls, St. Paul and Sault Ste Marie Railway Company, on the East to the West line of the land herein conveyed, which parcel comprises a part of Peet's First Addition to Danbury.

Southwest Quarter of the Southeast Quarter (SW1/4 SE1/4) of Section Twenty-eight, Township Forty-one (41) North of Range Sixteen (16) West.

Parcel Identification Number: 032-5328-04800

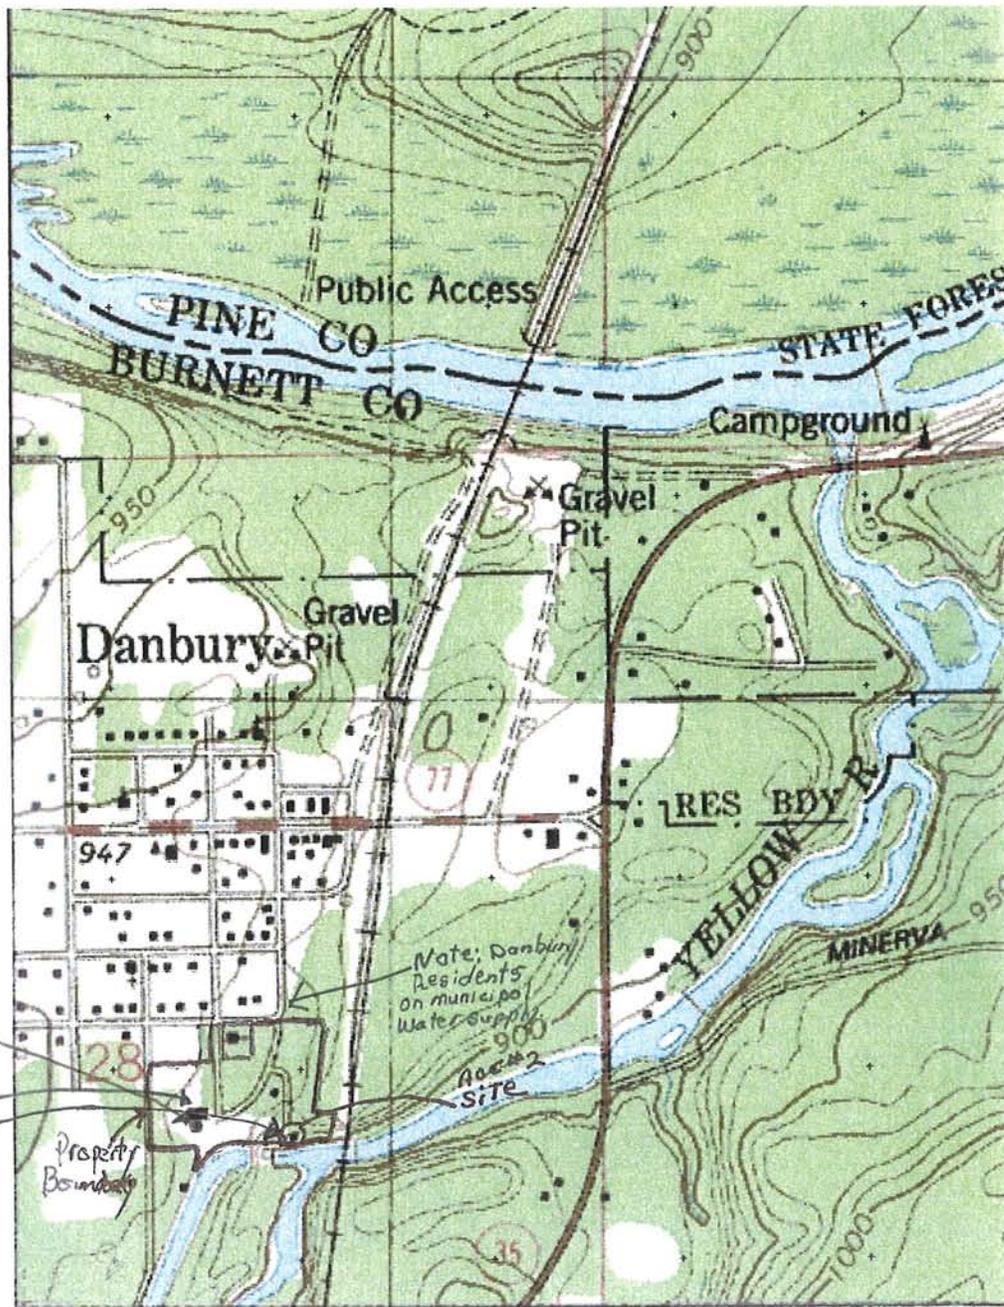

Scale
 1000'
 Turbine Plant Well (AOC #1)
 AOC #1 Area
 Residential Well Location (AOC #2)
 Property Boundary

2'30" OAKLAND 4.3 MI. WEBSTER 8 MI. 1 400 000 FEET

Danbury East
 Quadrangle



DRAWING FILENAME:
 DRAWING DIRECTORY:



1	X/XX/XX		RJH				
NO.	DATE	ISSUE/REVISIONS	DRAWN BY	DESIGN	FIELD REVIEW	QC CHECK	

Danbury Generating Facility - AOC #1
 Figure 2 - Location Map

PROJ. NO. XXXXXXX
DATE X/XX/XX

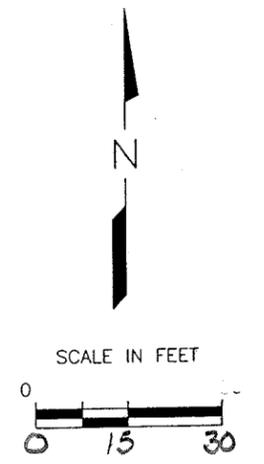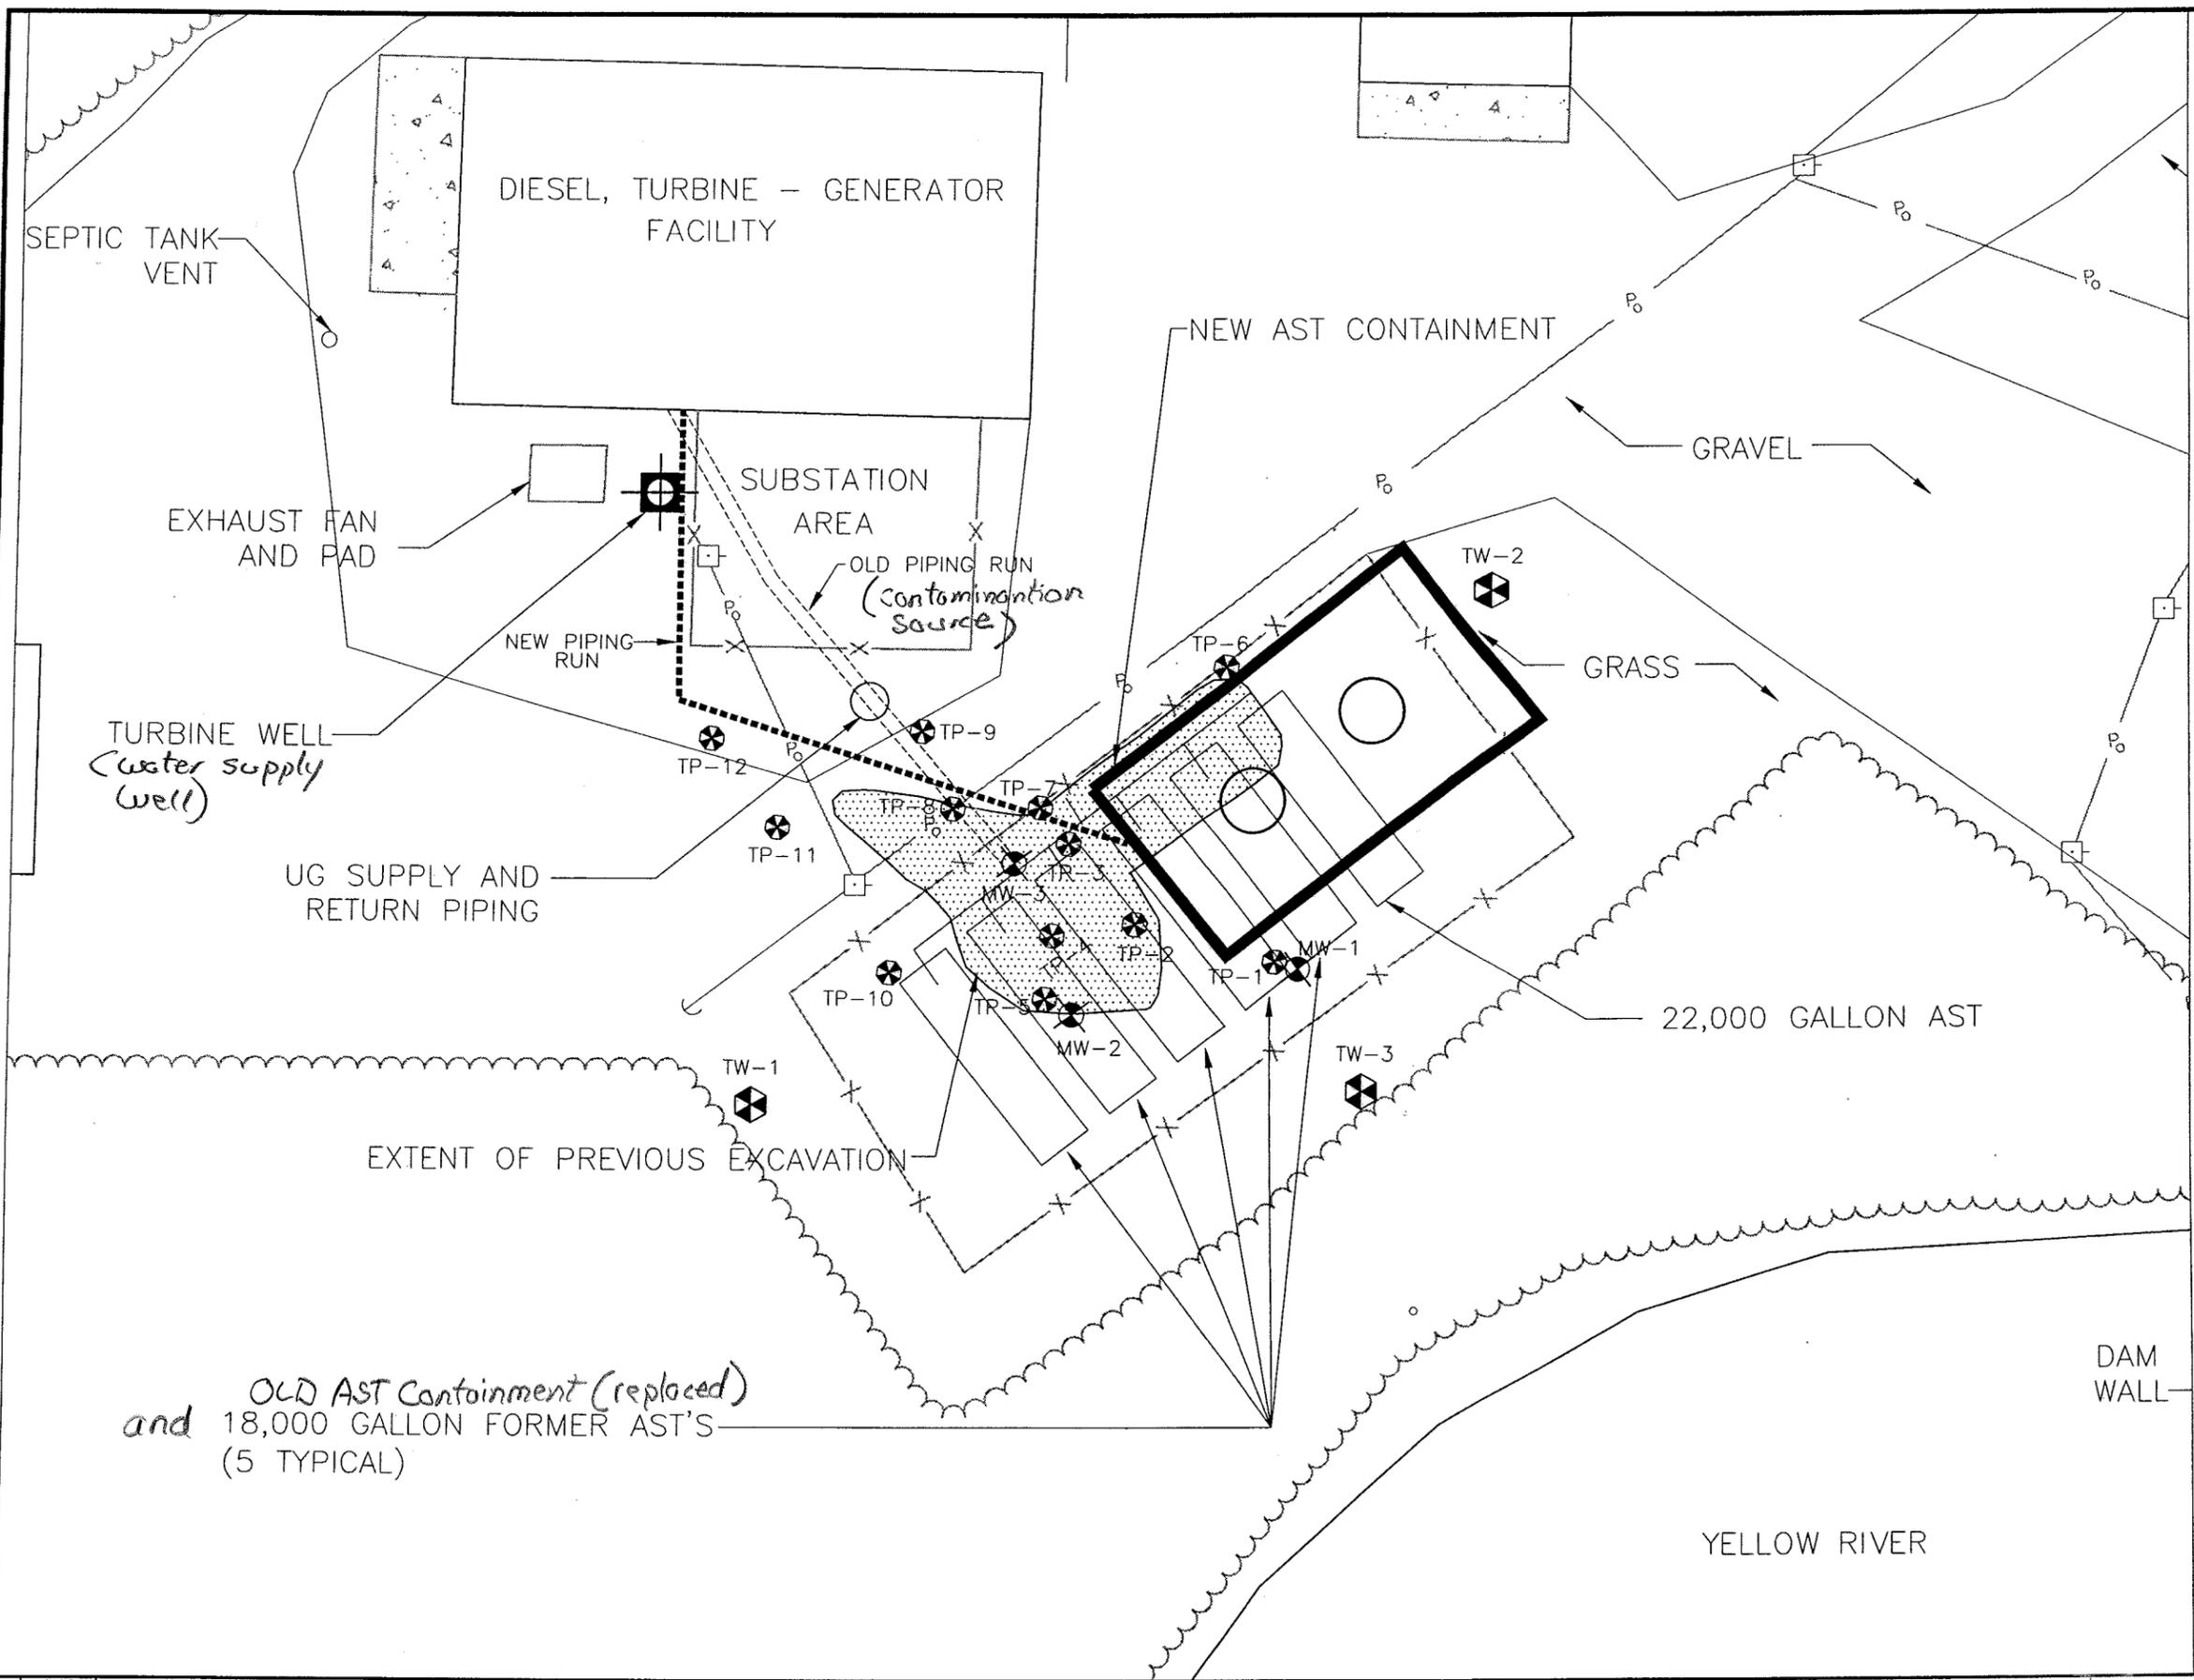

- LEGEND**
- - - - - FENCE
 - Po — OVERHEAD POWER LINES
 - ~~~~~ VEGETATION AREA
 - POWER POLE
 - ⊕ WELL WATER SUPPLY
 - TP-9 ⊗ GEOPROBE LOCATIONS
 - MW-3 ⊗ EXISTING GROUNDWATER MONITORING WELL

NOTES:

1. SITE PLAN CREATED FROM SURVEY CONDUCTED BY WAGNER SURVEYING OF WEBSTER, WISCONSIN. DATE OF SURVEY: JUNE 1999.

DRAWING DIRECTORY: P:\WORK\NWECC\070200\FIGURE 1 - TURBINE PLANT SITE PLAN

1	12/06/07		RJH	12/07	DRR	12/07		
NO.	DATE	ISSUE/REVISIONS	DRAWN BY	DESIGN	QC CHECK			





**NWEC DANBURY GENERATING FACILITY
TURBINE PLAN SITE FEATURES
DANBURY, WISCONSIN**

Danbury Generating Facility - AOC #1
Figure 3 - Detailed Site Map

PROJ. NO.
NWEC0702

DRAWING DIRECTORY: P:\00\NWEC\110122\FIGURES\FIGURE 1a - PROPERTY LINE AND PHYSICAL FEATURES

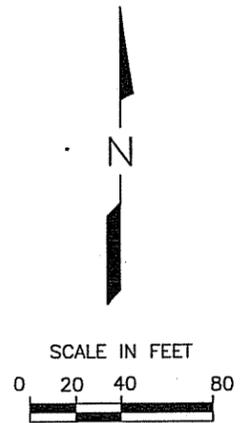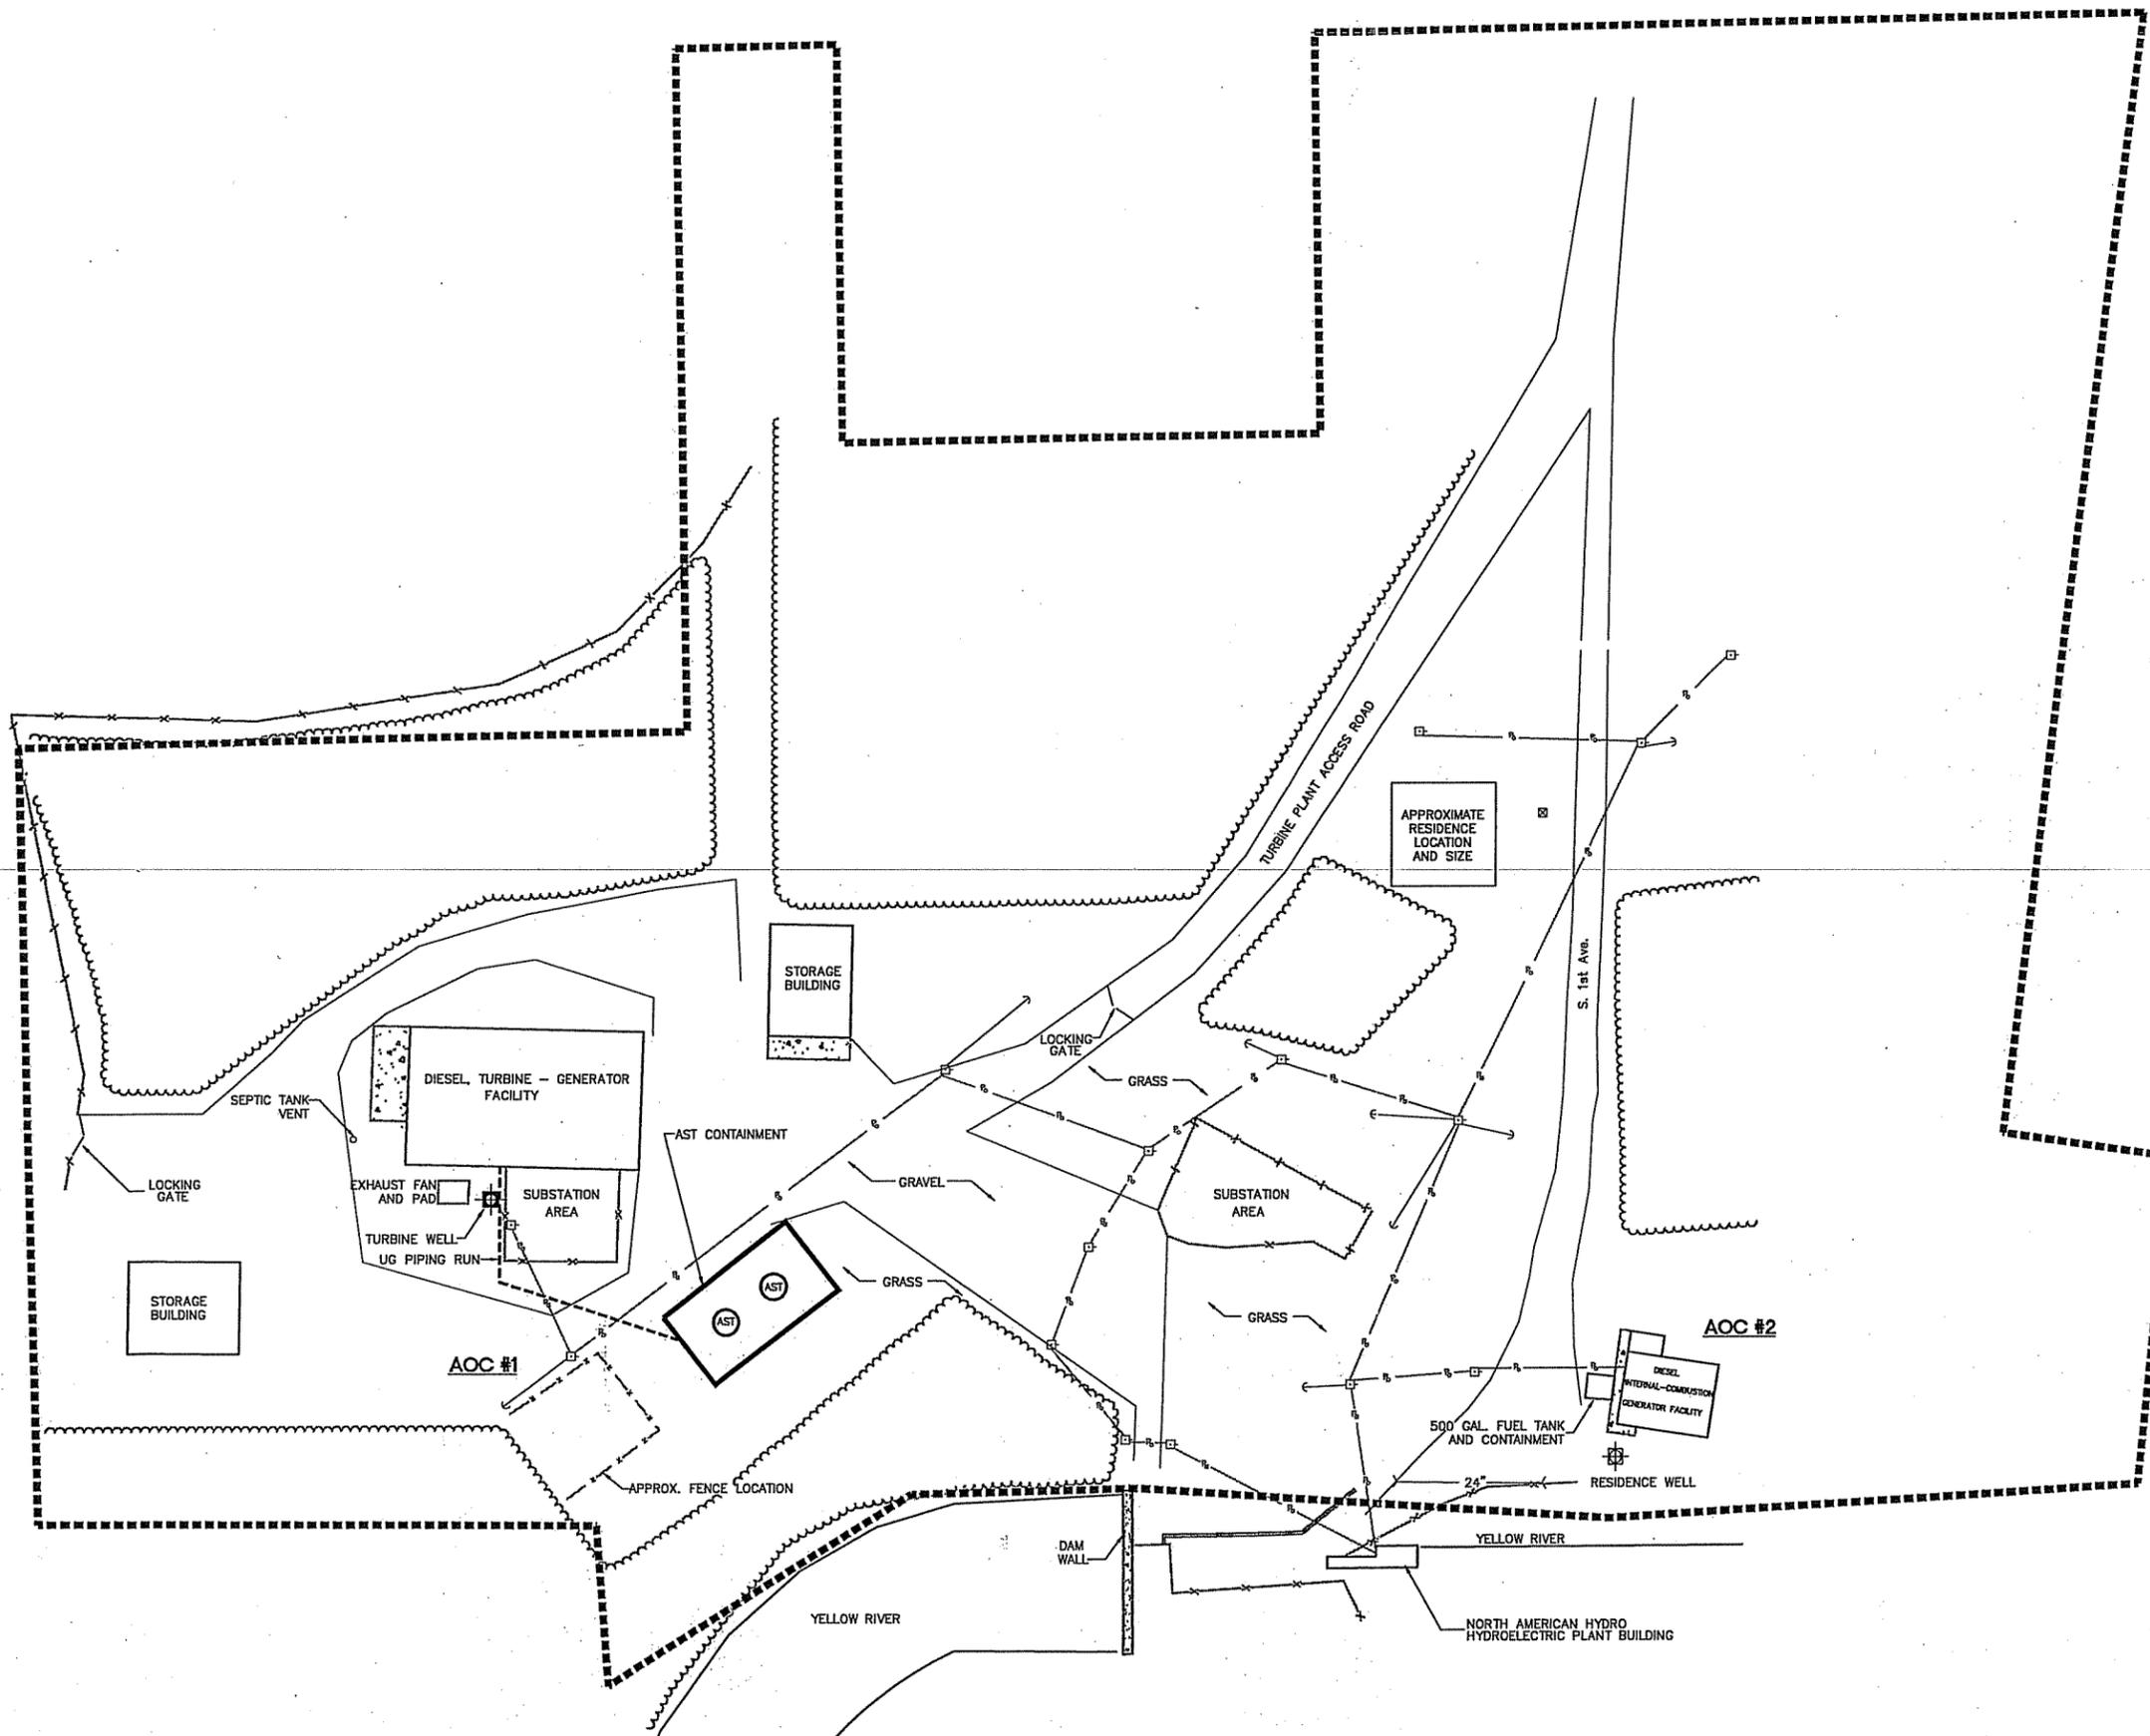

- LEGEND**
- FENCE
 - Po OVERHEAD POWER LINES
 - ~~~~ VEGETATION AREA
 - APPROXIMATE PROPERTY LINE
 - ⊕ RESIDENCE WELL
 - ⊞ POWER POLE
 - ⊞ TURBINE WELL (USED FOR COOLING)

NOTES:

- SITE PLAN CREATED FROM SURVEY CONDUCTED BY WAGNER SURVEYING OF WEBSTER, WISCONSIN. DATE OF SURVEY: JUNE 1999.

1	11/05/09		RJH	11/09	DRR	11/09	DRR	11/09
NO.	DATE	ISSUE/REVISIONS	DRAWN BY	DESIGN	QC CHECK			





NWEC DANBURY GENERATING FACILITY AOC #1
TURBINE PLANT SITE FEATURES
DANBURY, WISCONSIN


FIGURE 1a
PROPERTY LINE AND
PHYSICAL FEATURES

PROJ. NO. NWEC110122	1a
DATE 11/05/09	7

Cross Section A-A'

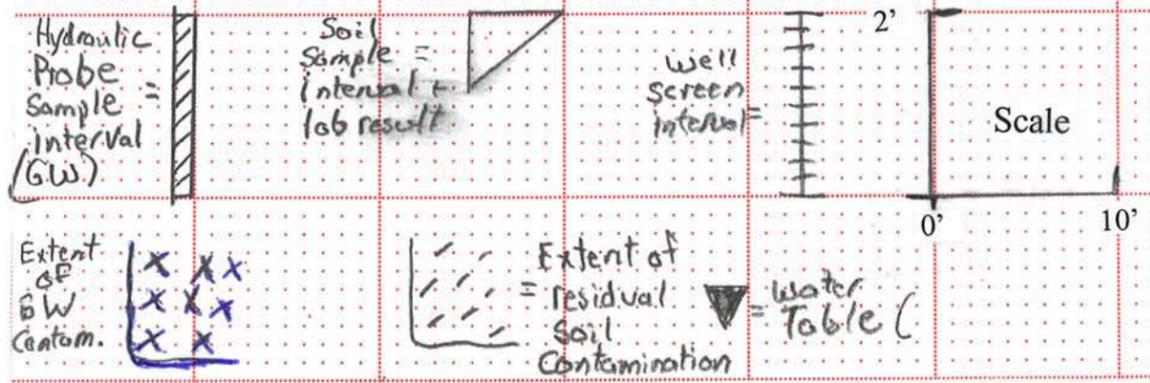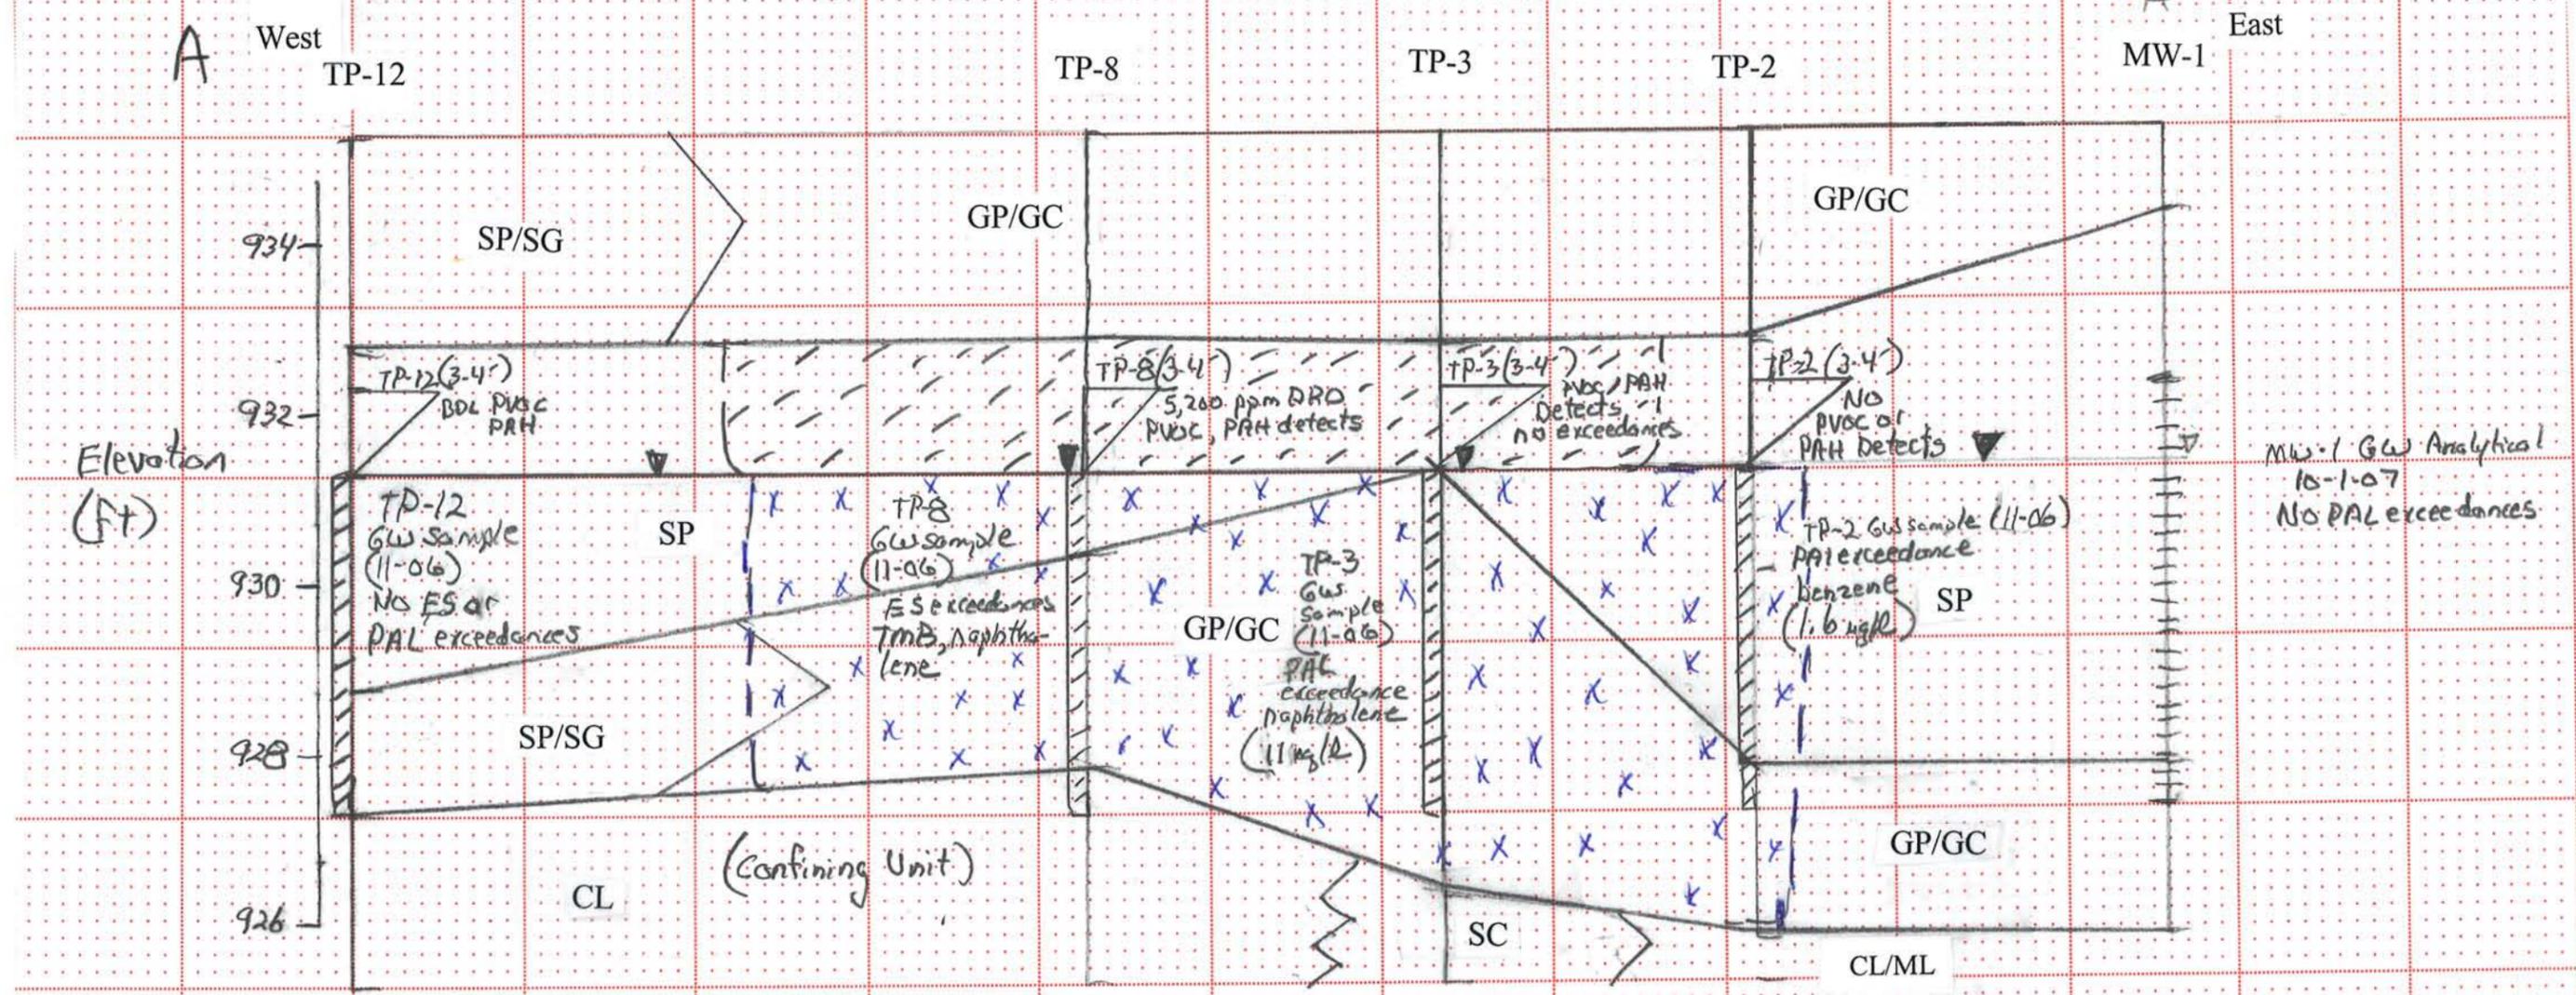


- SP/SG = Gravel / sand mixtures
- CL = Clays
- SC = Clayey sands
- GP/GC = Gravels and sand, gravels with clay
- CL/ML = Clayey silts, sandy clays, silty clays
- SP = Poorly graded sands

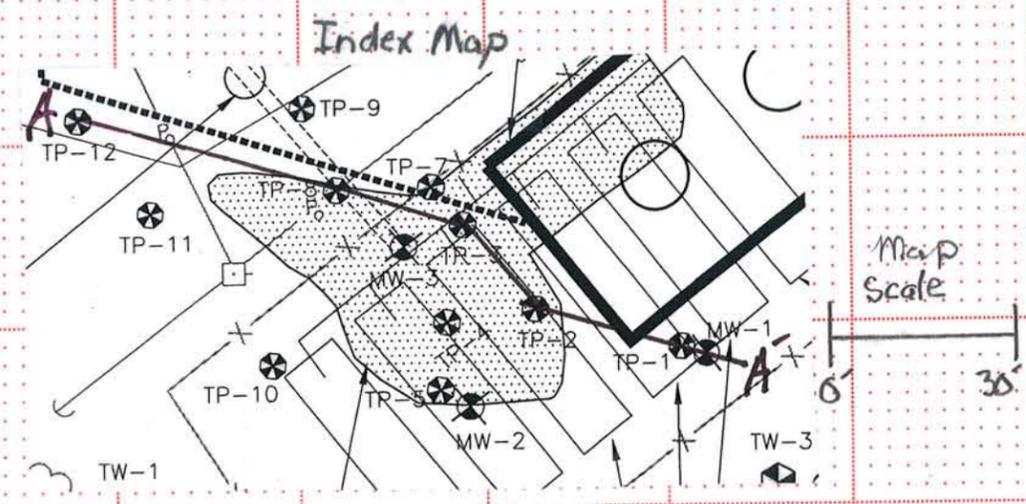



1	XX/XX/XX	REMEDIAL INVESTIGATION WORKPLAN	RJH	X/XX	XXX	X/XX	XXX	X/XX
NO.	DATE	ISSUE/REVISIONS	DRAWN BY	DESIGN	QC CHECK			

Cross Section B-B'

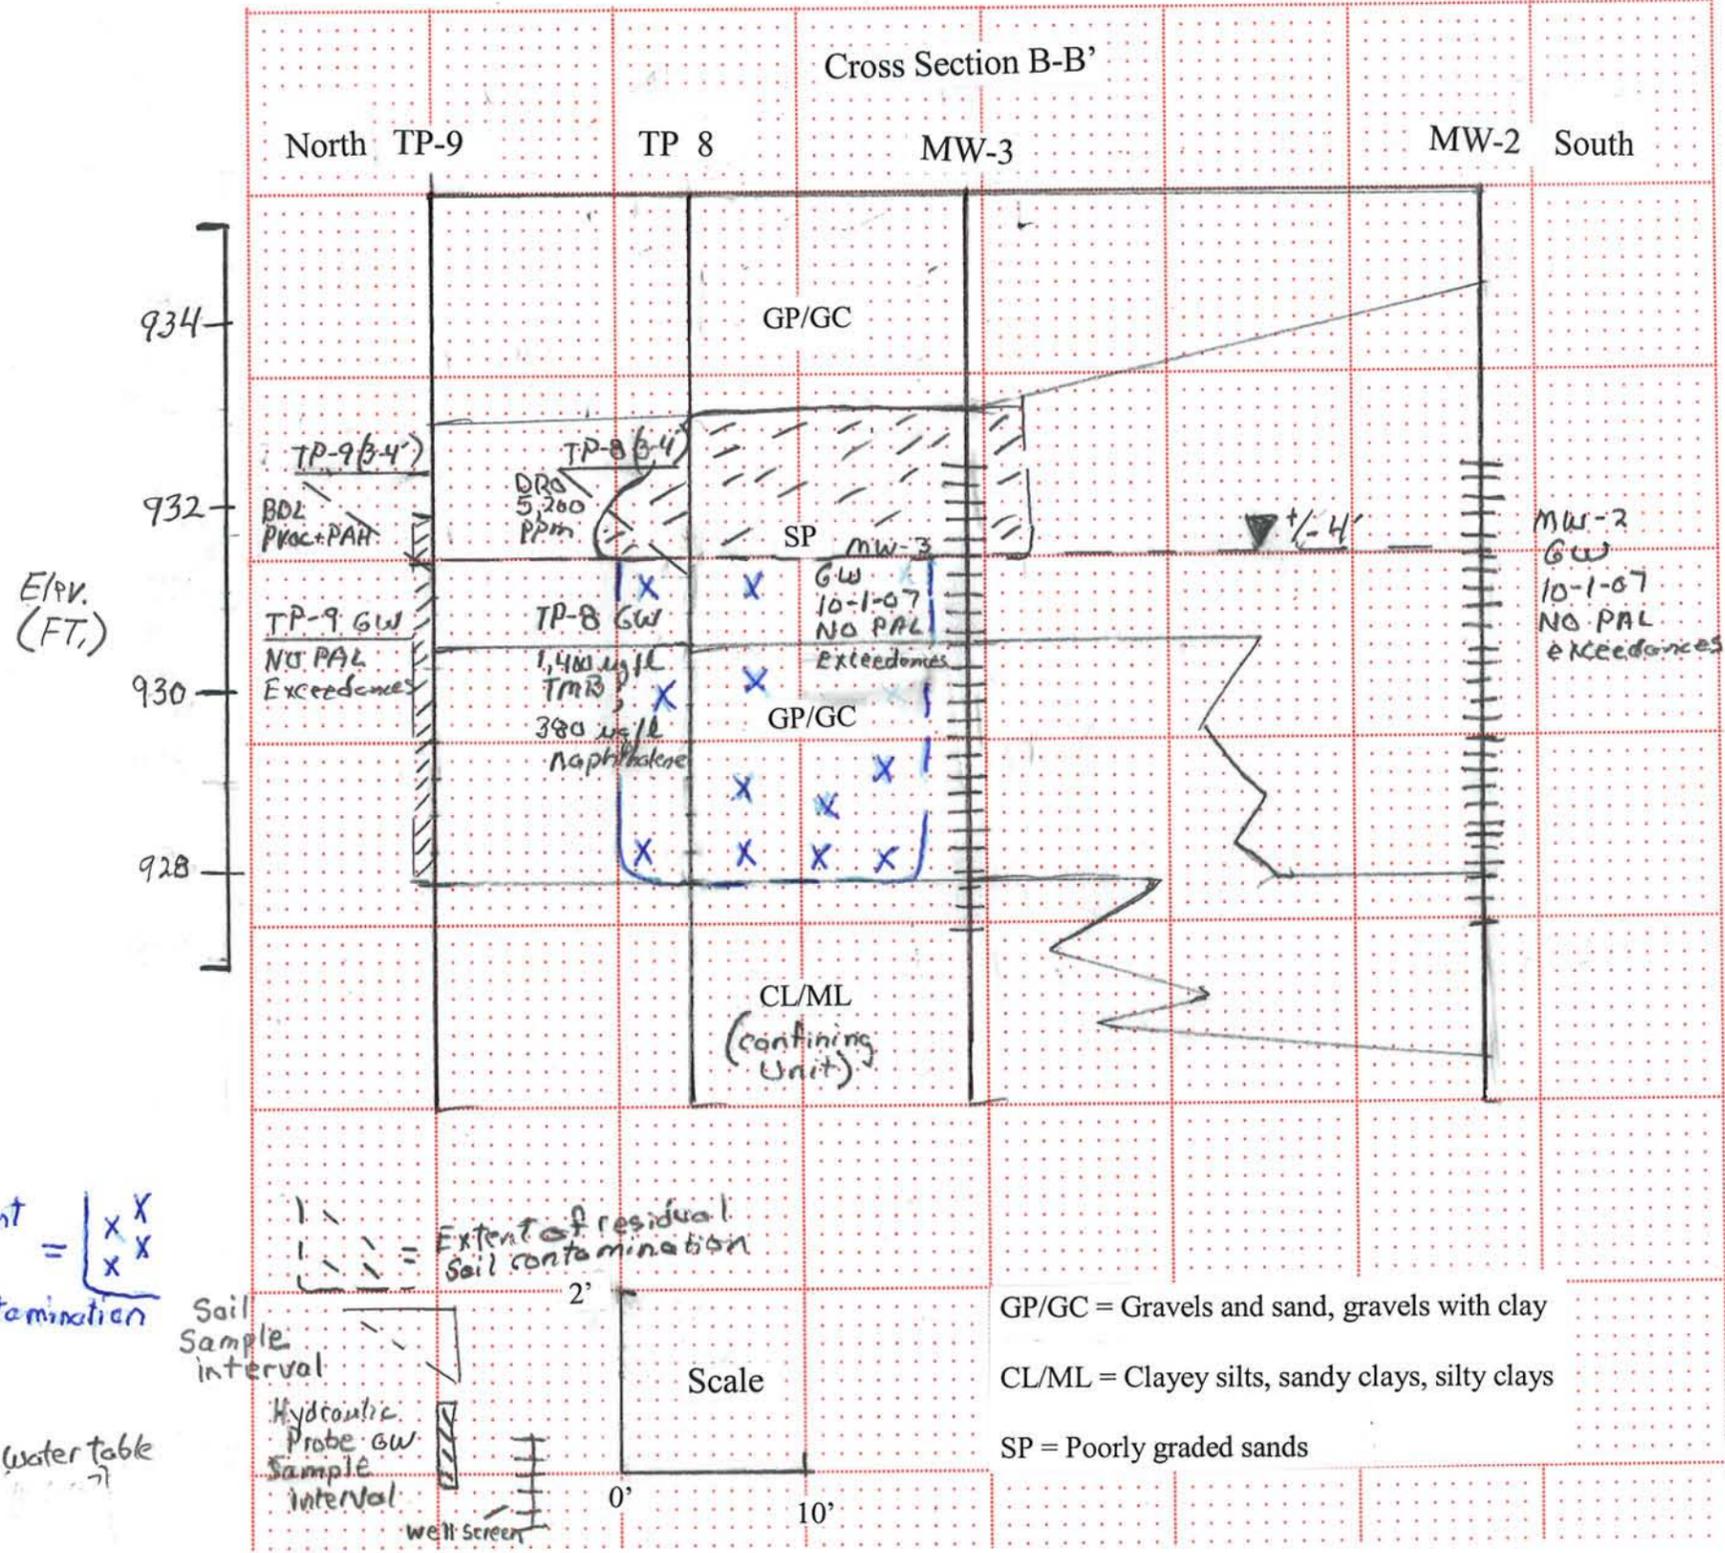


Index Map

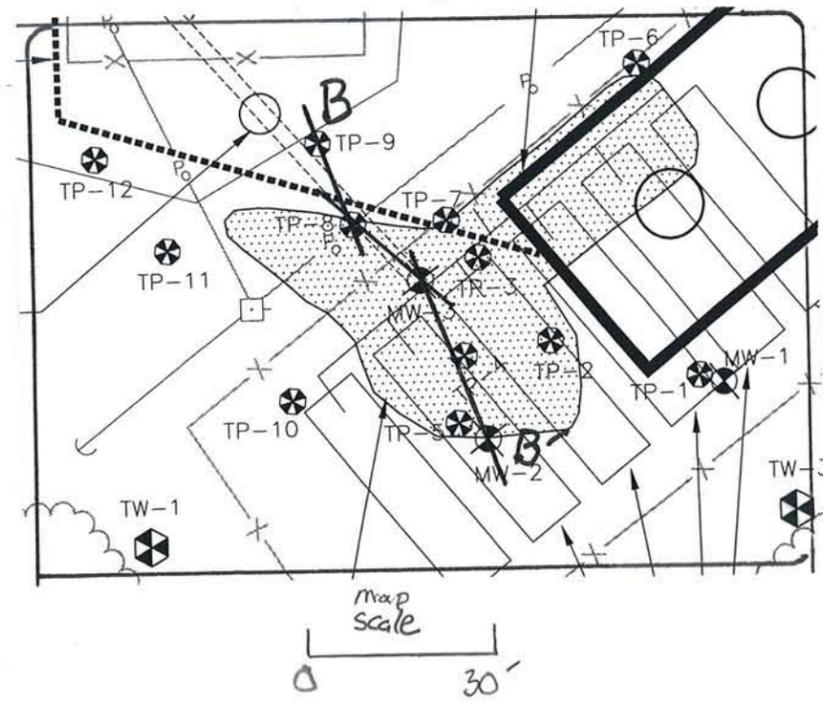

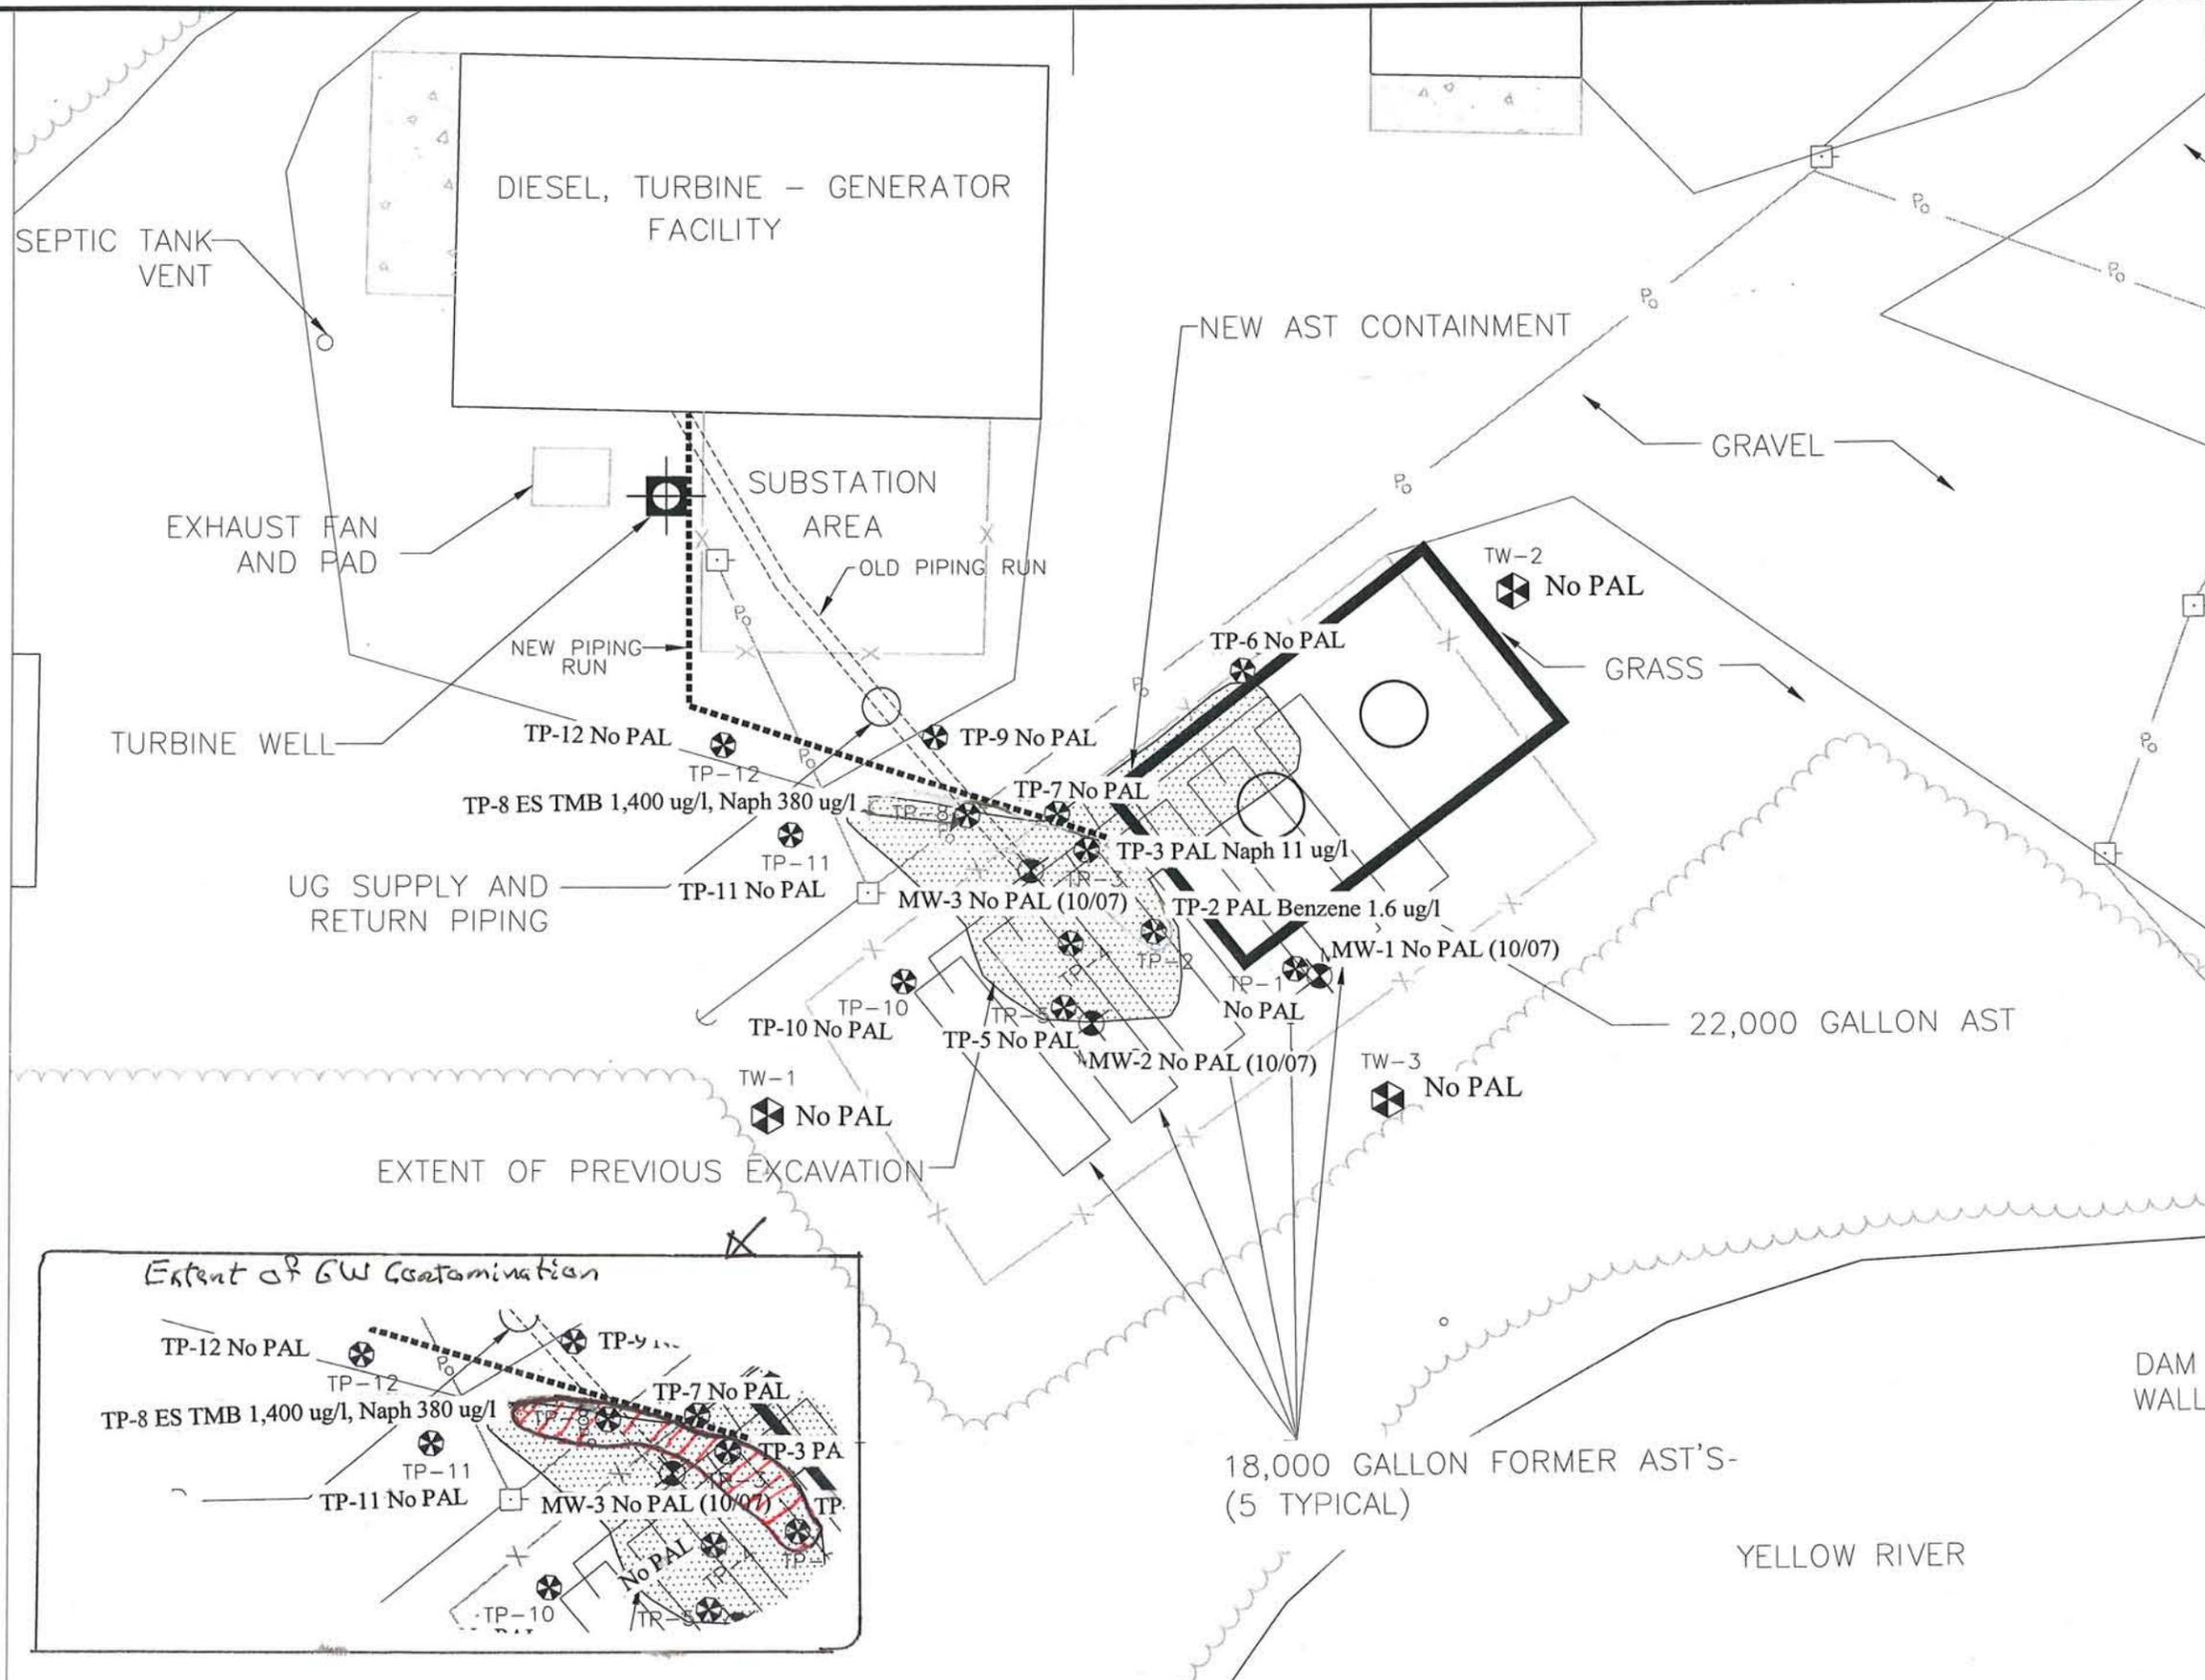

- LEGEND**
- FENCE
 - Pa --- OVERHEAD POWER LINES
 - ~~~~~ VEGETATION AREA
 - POWER POLE
 - ⊕ WELL WATER SUPPLY
 - ⊗ TP-9 GEOPROBE LOCATIONS (11/06)
 - ⊗ MW-3 EXISTING GROUNDWATER MONITORING WELL (12/06)
 - ⊗ TW-2 Temp Well (11/01/00)

- NOTES:**
1. SITE PLAN CREATED FROM SURVEY CONDUCTED BY WAGNER SURVEYING OF WEBSTER, WISCONSIN. DATE OF SURVEY: JUNE 1999.
 2. See groundwater analytical table for further details.
 3. PAL = CG.NR (40 Preventive Action Limit)
 4. Permanent MW analytical shown is for 1997 sampling event.

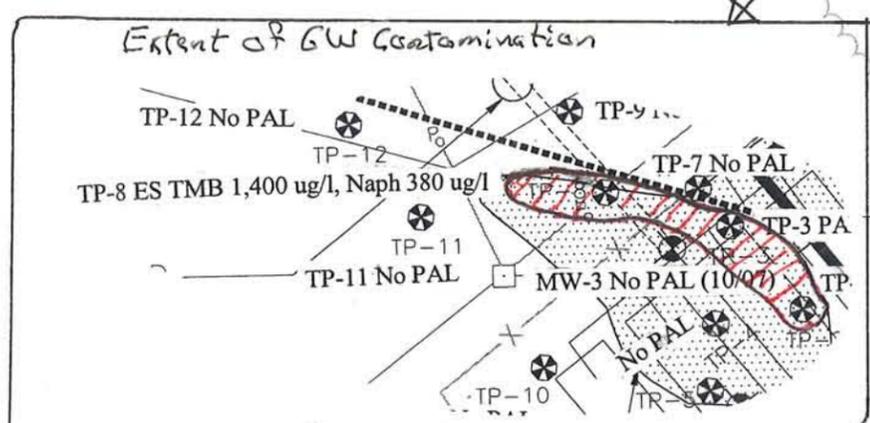

DRAWING DIRECTORY: P:\00\VA\NWEC\0702000\FIGURE 1 - TURBINE PLANT SITE PLAN



1	12/05/07	RJH	12/07	DRR	12/07
NO.	DATE	DRAWN BY	DESIGN	QC CHECK	

NWEC DANBURY GENERATING FACILITY
TURBINE PLANT SITE FEATURES
DANBURY, WISCONSIN

Danbury Generating Facility - AOC #1
Figure 7 - Groundwater Analytical Details

PROJ. NO.
NWEC0702

DRAWING DIRECTORY: G:\CO\NHEC\990200\FIGURES\SITE_INVESTIGATION\FIGURE 4 - GROUNDWATER CONTOURS

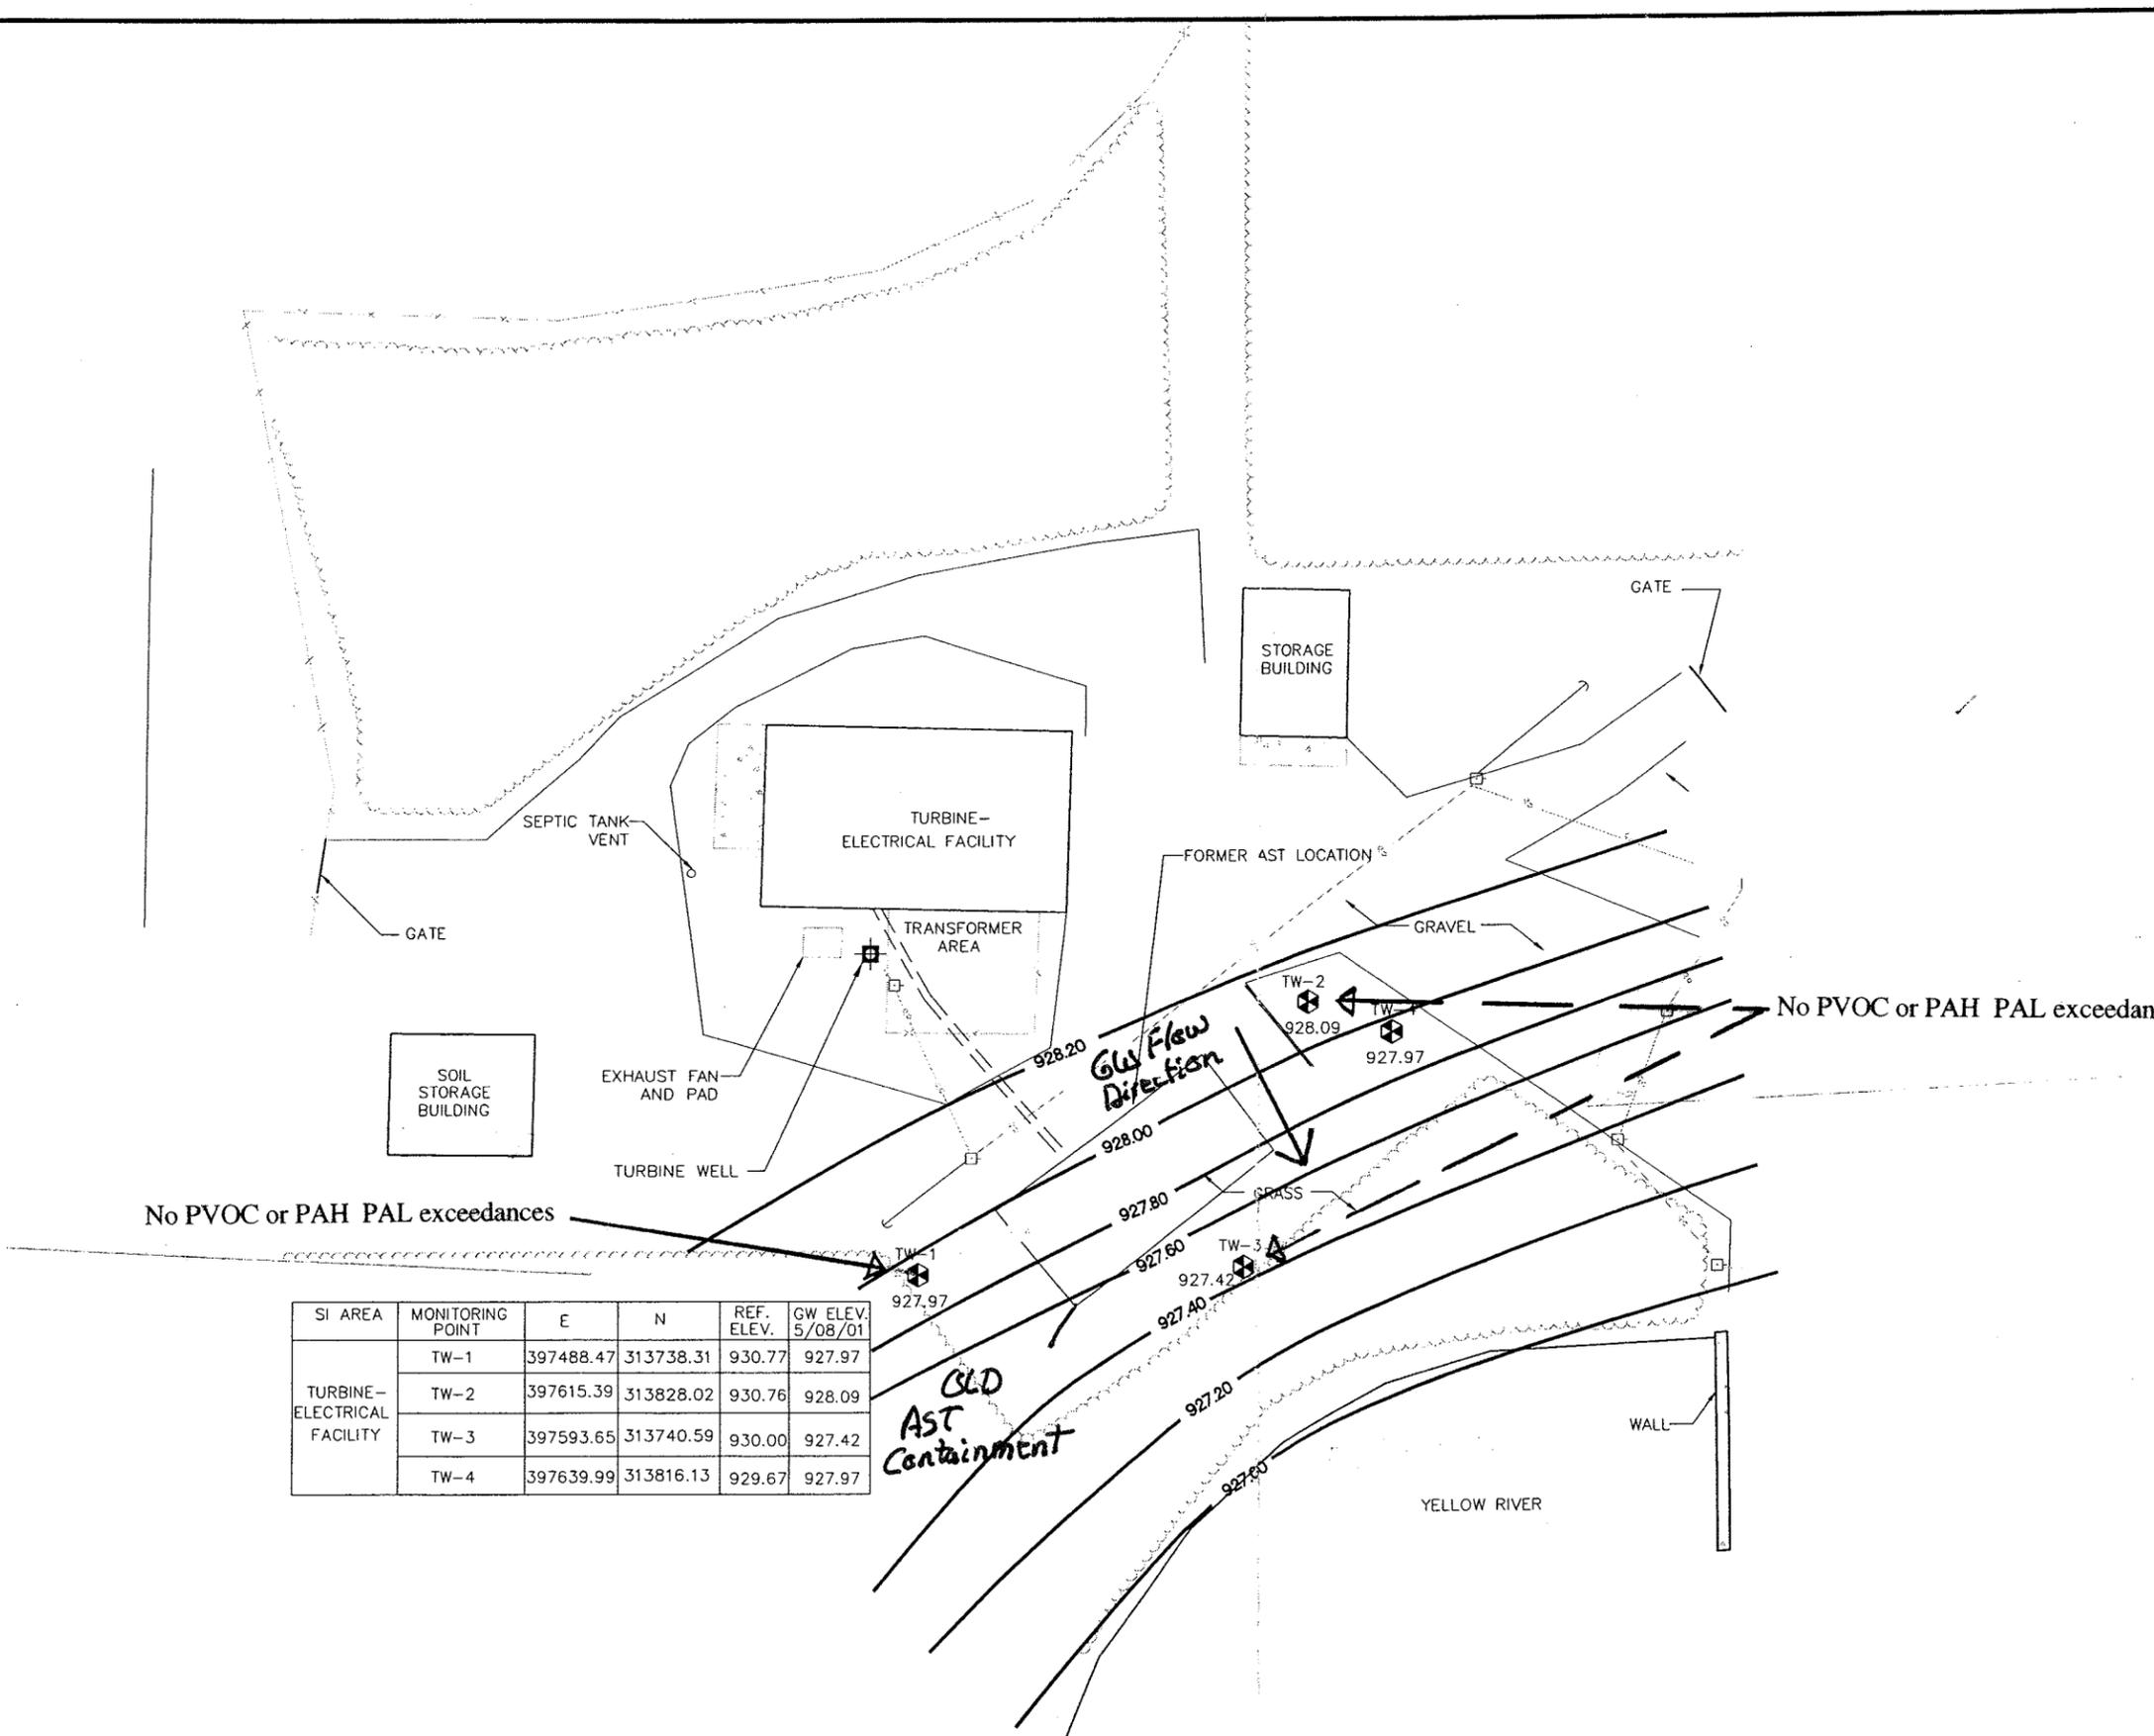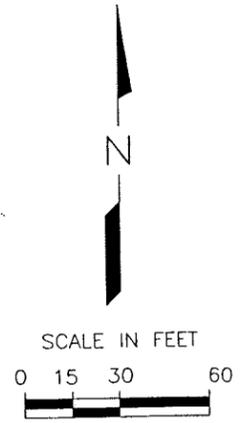

No PVOC or PAH PAL exceedances

No PVOC or PAH PAL exceedances

SI AREA	MONITORING POINT	E	N	REF. ELEV.	GW ELEV. 5/08/01
TURBINE-ELECTRICAL FACILITY	TW-1	397488.47	313738.31	930.77	927.97
	TW-2	397615.39	313828.02	930.76	928.09
	TW-3	397593.65	313740.59	930.00	927.42
	TW-4	397639.99	313816.13	929.67	927.97

LEGEND:

TW-9 HYDRAULIC PROBE GROUNDWATER SAMPLE LOCATION, NUMBER AND GROUNDWATER ELEVATION (5/8/01)

928.00 GROUNDWATER CONTOUR WITH GROUNDWATER ELEVATION (FT) CONTOUR INTERVAL = 0.2

Analytical results - 11/1/00

NOTES:

1. SITE PLAN CREATED FROM SURVEY CONDUCTED BY WAGNER SURVEYING OF WEBSTER, WISCONSIN. DATE OF SURVEY: JUNE 1999.



1	03/07/05	AOC #1	RJH	03/05	DRR	03/05
NO.	DATE	ISSUE/REVISIONS	DRAWN BY	DESIGN	QC CHECK	



NWEC DANBURY GENERATING FACILITY
TURBINE PLAN SITE FEATURES
DANBURY, WISCONSIN

Danbury Generating Facility - AOC #1
Figure 8 - Groundwater Contours - 11/00

DRAWING DIRECTORY: P:\NWEC\102411\TURBINE PLANT CLOSEOUT PACKAGE\FIGURES\FIGURE 9 - GROUNDWATER CONTOURS

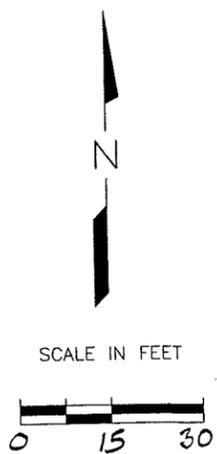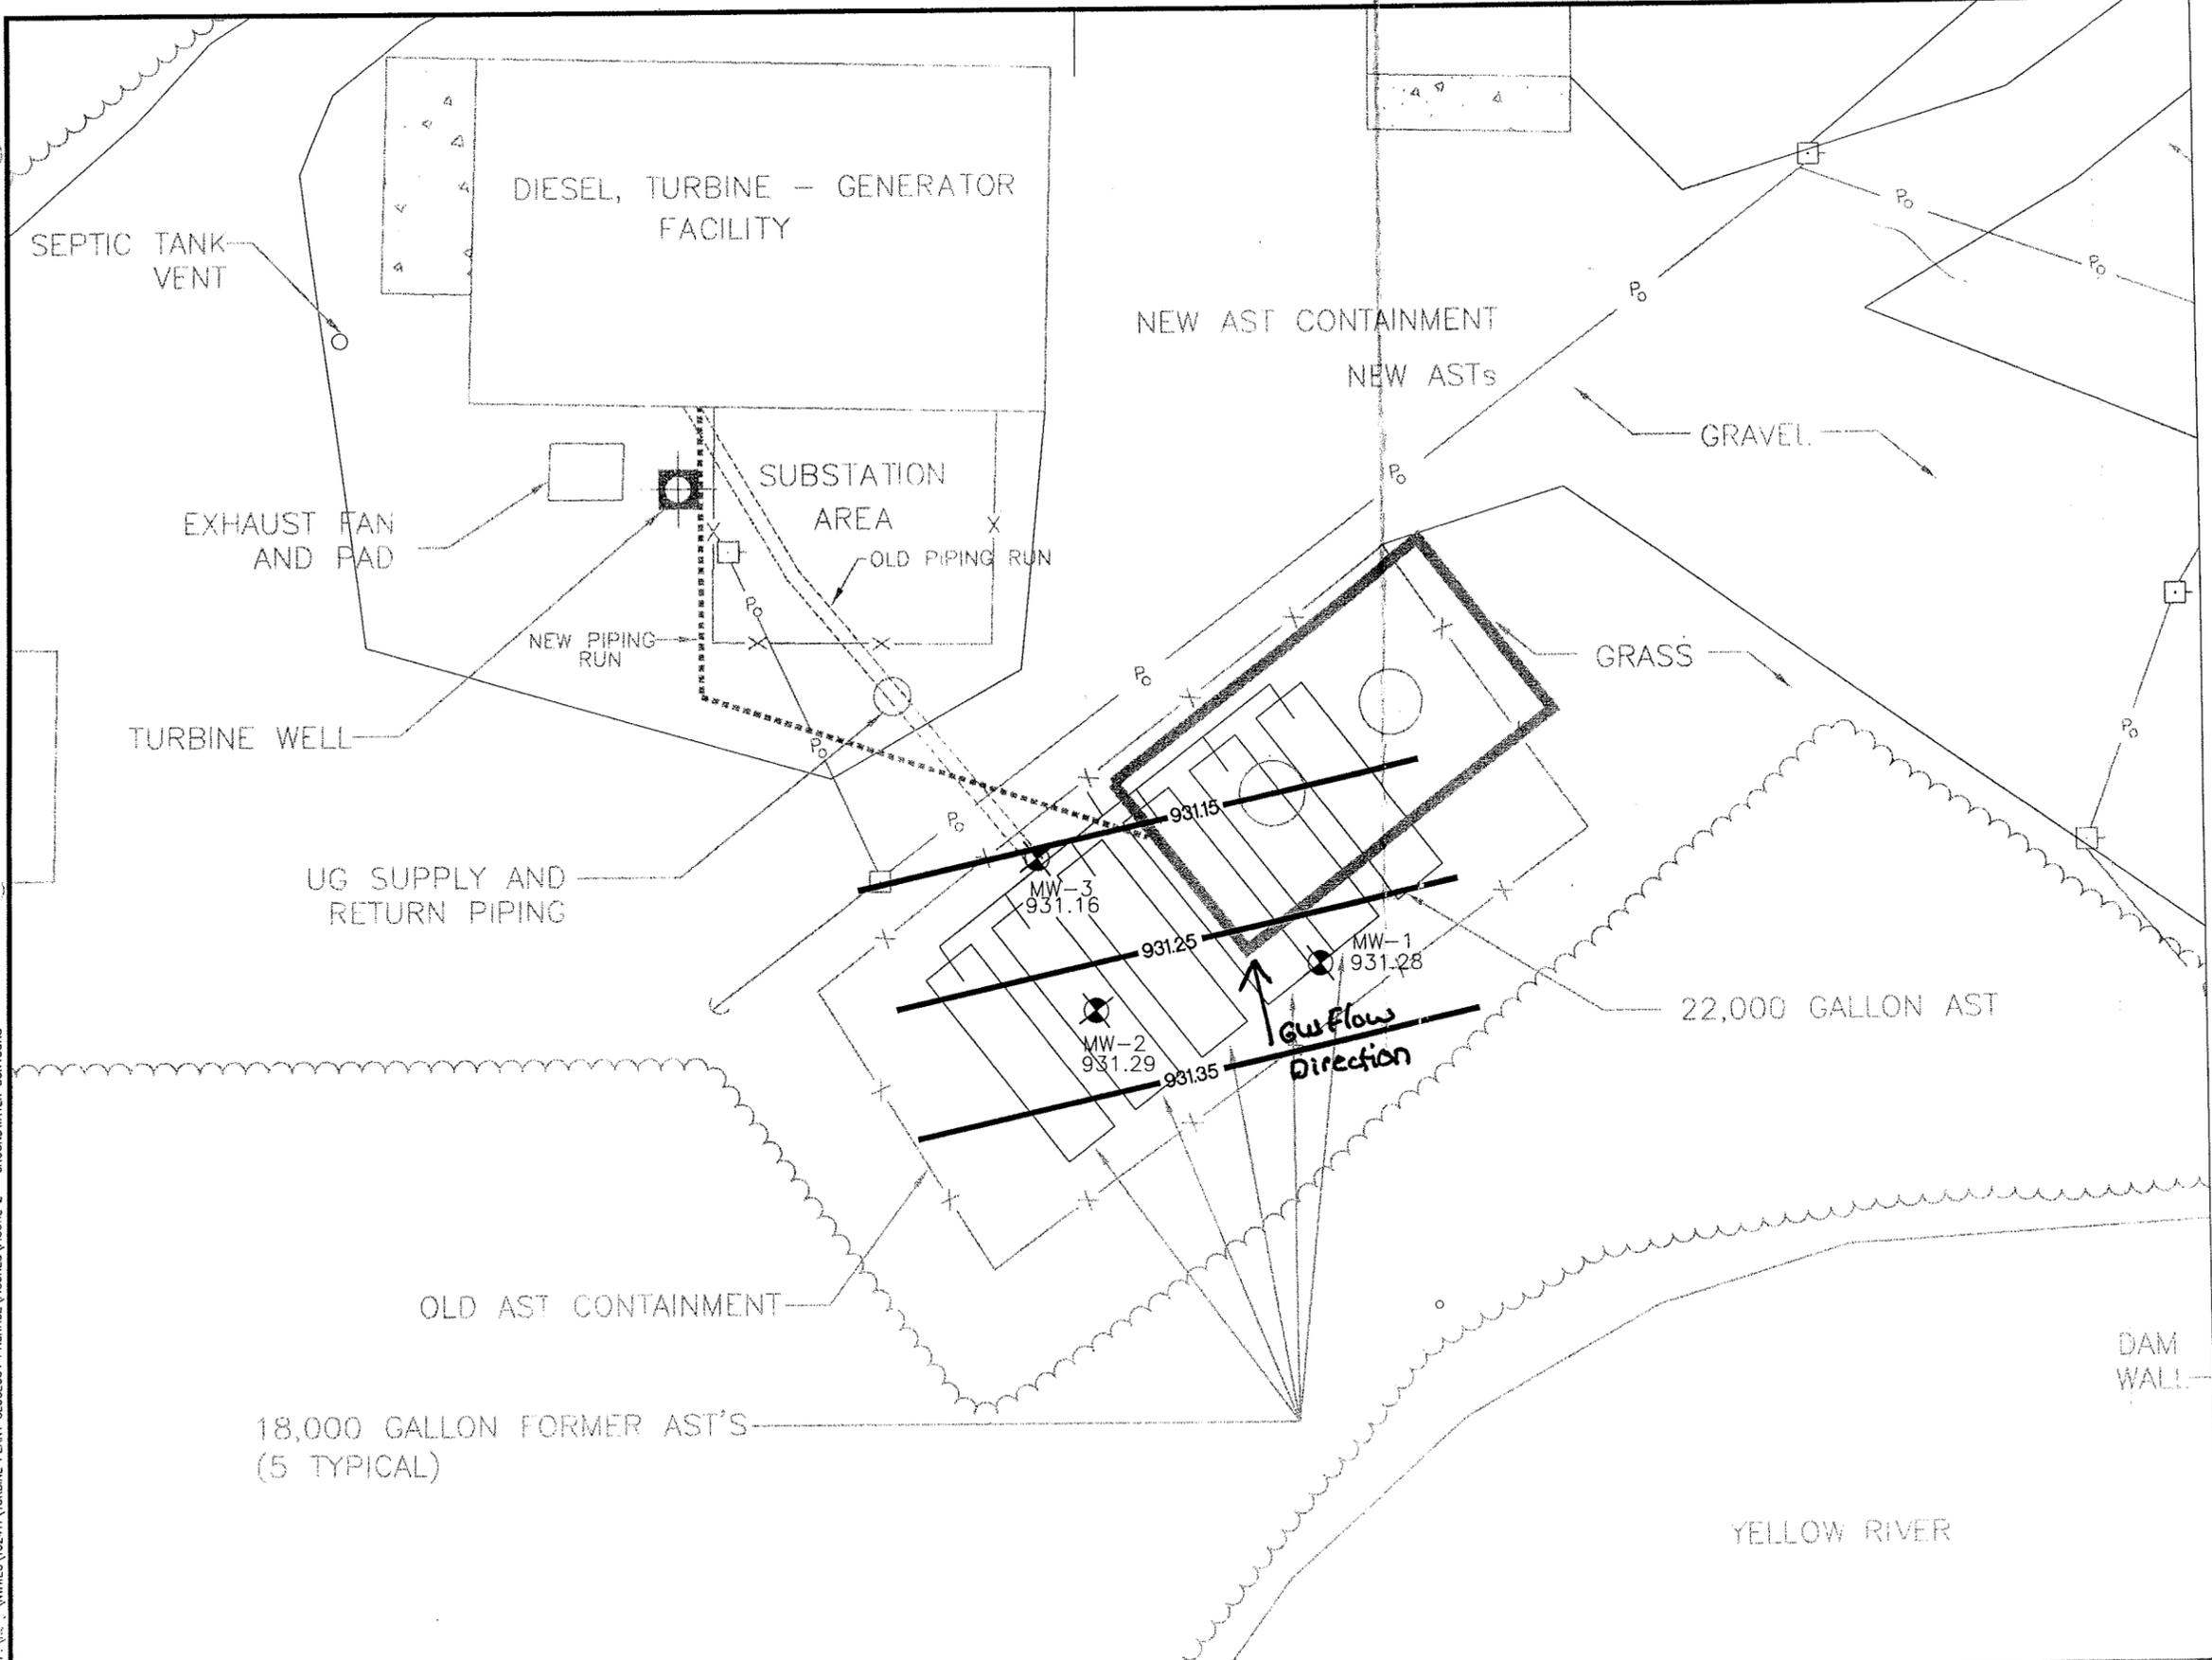

- LEGEND**
- FENCE
 - P₀ ----- OVERHEAD POWER LINES
 - ~~~~~ VEGETATION AREA
 - POWER POLE
 - ⊠ TURBINE PLANT WATER SUPPLY WELL
 - MW-3 ⊗ 931.28 EXISTING GROUNDWATER MONITORING WELL WITH 10/07 GROUNDWATER ELEVATION

- NOTES:**
1. SITE PLAN CREATED FROM SURVEY CONDUCTED BY WAGNER SURVEYING OF WEBSTER, WISCONSIN. DATE OF SURVEY: JUNE 1999.
 2. CONTOUR INTERVAL = 0.1 FEET

NO.	DATE	ISSUE/REVISIONS	DRAWN BY	DESIGN	QC CHECK
1	06/18/08		RJH	06/08	DRR

	NWEC DANBURY GENERATING FACILITY TURBINE PLANT DANBURY, WISCONSIN	Danbury Generating Facility - AOC #1 Figure 9 - Groundwater Contours - 10/07	PROJ. NO. NWEC102411
--	--	---	-------------------------

Danbury Generating Facility – AOC #1
Table 1 – Soil Analytical Results

Analytical Parameters	NR 746 Table 1 Values ¹ or NR 720 Soil Cleanup Standard	Suggested RCLs for PAHs ²		Facility/Sample No./Depth (ft)/Date										
				Excavation Soil Samples										
		Groundwater Pathway	Direct Contact Pathway, Industrial	TF-SS-1	TF-SS-2	TF-SS-3	TF-SS-4	TF-SS-5	TF-SS-6	WE-1	WE-2	WE-3	WE-4	B-1
				2'	2'	2'	2'	3'	3'	3'	3'	3'	3'	3'
				11/16/1999						6/26/2000				
DRO (mg/kg)	100	NA	NA	5,000	1.6	<1.1	<1.1	<1.1	<1.1	206	<6.29	<5.56	4,370	<6.18
PVOCs (µg/kg)														
Benzene	8,500	NA	NA	<4.0	<4.0	<4.0	<4.0	<4.0	<4.0	<25	<25	<25	<200	<25
Ethylbenzene	4,600	NA	NA	180	<5.0	<5.0	<5.0	<5.0	<5.0	<25	<25	<25	<200	<25
Methyl tert butyl ether	NSE	NA	NA	<8.0	<8.0	<8.0	<8.0	<8.0	<8.0	<25	<25	<25	<200	<25
Toluene	38,000	NA	NA	96	<7.0	<7.0	<7.0	<7.0	<7.0	<25	<25	<25	<200	<25
1,2,4-Trimethylbenzene	83,000	NA	NA	1,600	30	<9.0	<9.0	<9.0	25	<25	<25	<25	4,250	<25
1,3,5-Trimethylbenzene	11,000	NA	NA	1,500	11	<6.0	<6.0	<6.0	11	<25	<25	<25	2,990	<25
Total Xylenes	42,000	NA	NA	360	<21	<21	<21	<21	<21	<50	<50	<50	519	<50
PAHs (µg/kg)														
Acenaphthene	NSE	38,000	6,000,000	5,600	<22	<22	<22	<22	<22	--	<7.8	--	<6.81	--
Acenaphthylene	NSE	700	360,000	<440	<44	<44	<44	<44	<44	--	<5.28	--	<4.62	--
Anthracene	NSE	3,000,000	300,000,000	690	<2.3	<2.3	<2.3	<2.3	<2.3	--	<3.65	--	<3.19	--
Benzo(a)Anthracene	NSE	17,000	3,900	180	<2.4	<2.4	<2.4	<2.4	<2.4	--	<3.14	--	<2.75	--
Benzo(a)Pyrene	NSE	48,000	390	<18	<1.8	<1.8	<1.8	<1.8	<1.8	--	<2.89	--	<2.53	--
Benzo(b)Fluoranthene	NSE	360,000	3,900	<41	<4.1	<4.1	<4.1	<4.1	<4.1	--	<1.38	--	<1.21	--
Benzo(k)Fluoranthene	NSE	870,000	39,000	<17	<1.7	2.7	<1.7	<1.7	<1.7	--	<1.51	--	<1.32	--
Benzo(ghi)Perylene	NSE	6,800,000	39,000	<46	<4.6	<4.6	<4.6	<4.6	<4.6	--	<1.26	--	<1.1	--
Chrysene	NSE	37,000	390,000	<26	<2.6	<2.6	<2.6	<2.6	<2.6	--	<2.52	--	<2.2	--
Dibenzo(a,h)Anthracene	NSE	38,000	390	<23	<2.3	<2.3	<2.3	<2.3	<2.3	--	<1.76	--	<1.54	--
Fluoranthene	NSE	500,000	40,000,000	1,400	<4.3	<4.3	<4.3	<4.3	<4.3	--	<3.27	--	<2.86	--
Fluorene	NSE	100,000	40,000,000	<44	<4.4	<4.4	<4.4	<4.4	<4.4	--	<4.4	--	<3.85	--
Indeno(1,2,3-cd)Pyrene	NSE	680,000	3,900	<17	<1.7	<1.7	<1.7	<1.7	<1.7	--	<2.14	--	<1.87	--
1-Methyl Naphthalene	NSE	23,000	70,000,000	<230	<23	<23	<23	<23	<23	--	<3.65	--	<3.19	--
2-Methyl Naphthalene	NSE	20,000	40,000,000	3,000	<21	<21	<21	<21	<21	--	<2.89	--	<2.53	--
Naphthalene	2,700	400	110,000	<210	<21	<21	<21	<21	<21	--	<4.91	--	<4.29	--
Phenanthrene	NSE	1,800	390,000	460	<2.1	<2.1	<2.1	<2.1	<2.1	--	<2.01	--	<1.76	--
Pyrene	NSE	8,700	30,000	740	<2.0	<2.0	<2.0	<2.0	<2.0	--	<3.9	--	<3.41	--

NSE = No standard established

¹ = NR 746.06(2) Wis. Admin. Code Table 1 risk screening levels for Indicators of Residual Petroleum Product in Soil Pores

² = From Table 1, WDNR Publication RR-519-97, "Soil Cleanup Levels for Polycyclic Aromatic Hydrocarbons (PAHs) Interim Guidance".

NA = Not applicable

Compiled by: BLK Checked by: DRR

Q:\KO\Nwwec\990200\Reports&Specs\misc\soil analres-AOC1.xls

Danbury Generating Facility – AOC #1
Table 1 – Soil Analytical Results

Analytical Parameters	Wis. Adm. Code Standards		Boring No./Depth (ft)/Date											
			TP-1	TP-2	TP-3	TP-4	TP-5	TP-6	TP-7	TP-8	TP-9	TP-10	TP-11	TP-12
	720	746	3-4	3-4	3-4	3-4	3-4	3-4	3-4	3-4	3-4	3-4	3-4	3-4
			11/15/06											
DRO (mg/kg)	100	NSE	--	--	--	--	--	--	--	5,200	--	--	--	--
PVOCs (µg/kg)														
Benzene	5.5	8,500	<29	<29	<27	<27	<28	<28	<28	<270	<28	<30	<27	<27
Ethylbenzene	2,900	4,600	<29	<29	<27	<27	<28	<28	<28	<270	<28	<30	<27	<27
Methyl tert butyl ether	NSE	NSE	<29	<29	<27	<27	<28	<28	<28	<270	<28	<30	<27	<27
Toluene	1,500	38,000	<29	<29	<27	<27	<28	<28	<28	<270	<28	<30	<27	<27
1,2,4-Trimethylbenzene	NSE	83,000	<29	<29	190	<27	<28	<28	<28	2,900	<28	<30	<27	<27
1,3,5-Trimethylbenzene	NSE	11,000	<29	<29	<27	<27	<28	<28	<28	<270	<28	<30	<27	<27
Total Xylenes	4,100	42,000	<87	<87	<82	<81	<83	<83	<83	<800	<83	<91	<82	<82
PAHs (mg/kg)*	Generic RCLs in Soil													
	Groundwater Pathway	Direct Contact-Industrial												
Acenaphthene	38	60,000	<0.058	<0.058	<0.055	<0.054	<0.055	<0.055	<0.057	<0.33	<0.055	<0.06	<0.055	<0.055
Acenaphthylene	0.7	360	<0.098	<0.098	<0.093	<0.092	<0.094	<0.094	<0.096	<0.56	<0.094	<0.100	<0.093	<0.093
Anthracene	3,000	300,000	<0.0058	<0.0058	<0.0055	<0.0054	<0.0055	<0.0055	<0.0057	0.130	<0.0055	<0.006	<0.0055	<0.0055
Benzo(a)Anthracene	17	3.9	<0.0058	<0.0058	0.015	<0.0054	<0.0055	<0.0055	<0.0057	0.430	<0.0055	<0.006	<0.0055	<0.0055
Benzo(a)Pyrene	48	0.39	<0.0058	<0.0058	0.019	<0.0054	<0.0055	<0.0055	<0.0057	<0.033	<0.0055	<0.006	<0.0055	<0.0055
Benzo(b)Fluoranthene	6,800	3.9	<0.0058	<0.0058	0.0083	<0.0054	<0.0055	<0.0055	<0.0057	<0.033	<0.0055	<0.006	<0.0055	<0.0055
Benzo(k)Fluoranthene	870	39	<0.0058	<0.0058	0.0075	<0.0054	<0.0055	<0.0055	<0.0057	<0.033	<0.0055	<0.006	<0.0055	<0.0055
Benzo(ghi)Perylene	6,800	39	<0.0058	<0.0058	0.0059	<0.0054	<0.0055	<0.0055	<0.0057	<0.033	<0.0055	<0.006	<0.0055	<0.0055
Chrysene	37	390	<0.0058	<0.0058	0.016	<0.0054	<0.0055	<0.0055	<0.0057	0.110	<0.0055	<0.006	<0.0055	<0.0055
Dibenzo(a,h)Anthracene	38	0.39	<0.0087	<0.0087	<0.0082	<0.0081	<0.0083	<0.0083	<0.0085	<0.049	<0.0083	<0.0091	<0.0082	<0.0082
Fluoranthene	500	40,000	<0.012	<0.012	0.022	<0.011	<0.011	<0.011	<0.011	0.560	<0.011	<0.012	<0.011	<0.011
Fluorene	100	40,000	<0.012	<0.012	<0.011	<0.011	<0.011	<0.011	<0.011	0.300	<0.011	<0.012	<0.011	<0.011
Indeno(1,2,3-cd)Pyrene	680	3.9	<0.0058	<0.0058	0.0072	<0.0054	<0.0055	<0.0055	<0.0057	<0.033	<0.0055	<0.006	<0.0055	<0.0055
1-Methyl Naphthalene	23	70,000	<0.035	<0.035	<0.033	<0.032	<0.033	<0.033	<0.034	0.670	<0.033	<0.036	<0.033	<0.033
2-Methyl Naphthalene	20	40,000	<0.029	<0.029	<0.027	<0.027	<0.028	<0.028	<0.028	0.770	<0.028	<0.030	<0.027	<0.027
Naphthalene	0.4	2.7**	<0.035	<0.035	<0.033	<0.032	<0.033	<0.033	<0.034	<0.2	<0.033	<0.036	<0.033	<0.033
Phenanthrene	1.8	390	<0.0058	<0.0058	<0.0055	<0.0054	<0.0055	<0.0055	<0.0057	0.190	<0.0055	<0.006	<0.0055	<0.0055
Pyrene	8,700	30,000	<0.0058	<0.0058	0.021	<0.0054	<0.0055	<0.0055	<0.0057	0.750	<0.0055	<0.006	<0.0055	<0.0055

NSE = No standard established
 * = Suggested generic residual contaminant levels (RCLs) for PAH compounds in soil
 ** = NR 746.06 Table 1 value
 -- = Not analyzed for
 mg/kg = milligrams per kilogram (ppm)
 µg/kg = micrograms per kilogram (ppb)
 Compiled by: DRR Checked by: XXX

P:\KOWN\wec\070200\Reports&Specs\misc\Hyd Push Soil Results-Turbine Plant.xls

Danbury Generating Facility – AOC #1
 Table 1 – Soil Analytical Results

Analytical Parameters	Wis. Adm. Code Standards		Boring No./Depth (ft)/Date			
			TP-DRO-1	TP-DRO-2	TP-DRO-3	TP-DRO-4
	720	746	3-4	3-4	3-4	3-4
			5/14/08			
DRO (mg/kg)	100	NSE	<5.3	<4.9	<5.6	<5.1
PVOCs (µg/kg)			--	--	--	--
NSE = No standard established -- = Not analyzed for mg/kg = milligrams per kilogram (ppm) Compiled by: <u>DRR</u> Checked by: <u>XXX</u>						
P:\KO\N\wwec\070200\Reports&Specs\misc\Hyd Push Soil Results-Turbine Plant.xls						

Danbury Generating Facility – AOC #1

Table 2 – Groundwater Analytical Results

Monitoring Well/Drinking Water Well Groundwater Analytical Results - Turbine Plant

Analytical Parameters	NR 140 Standards		Well No./Sampling Date																				
			TW-1	TW-2	TW-3	Turbine Well (Drinking Water)					TP-MW-1				TP-MW-2				TP-MW-3				
	ES	PAL	11/01/00	11/01/00	11/01/00	12/08/03	12/17/04	12/19/05	12/12/06	12/07/07	12/18/08	12/13/06	03/13/07	06/11/07	10/01/07	12/13/06	03/13/07	06/11/07	10/01/07	12/14/06	03/13/07	06/11/07	10/01/07
PVOCs (µg/l)																							
Benzene	5.0	0.5	<0.15	<0.15	<0.15	<0.31	<0.31	<0.31	<0.25	<0.25	<0.25	<0.25	<0.25	--	<0.25	<0.25	<0.25	--	<0.25	<0.25	<0.25	--	<0.25
Ethylbenzene	700	140	<0.5	<0.5	<0.5	<0.5	<0.5	<0.5	<0.22	<0.22	<0.22	<0.22	<0.22	--	<0.22	<0.22	<0.22	--	<0.22	8.0	2.7	--	0.39
Methyl tert butyl ether	60	12	<0.3	<0.3	<0.3	<0.3	<0.3	<0.3	<0.23	<0.23	<0.23	<0.23	<0.23	--	<0.23	<0.23	<0.23	--	<0.23	<0.23	<0.23	--	<0.23
Toluene	1,000	200	<0.4	<0.4	<0.4	<0.3	<0.3	<0.3	<0.11	0.75	<0.25	0.13	<0.11	--	0.16	<0.11	<0.11	--	0.15	<0.11	<0.11	--	<0.11
Total Trimethylbenzenes	480	96	<0.55	<0.55	<0.55	<0.71	<0.71	<0.71	<0.44	<0.44	<0.44	<0.44	<0.44	--	<0.44	<0.44	<0.44	--	<0.44	41.2	20.7	--	<1.49
Total Xylenes	10,000	1,000	<0.55	<0.55	<0.55	<0.93	<0.92	<0.92	<0.39	0.71	<0.39	<0.39	<0.39	--	<0.39	<0.39	<0.39	--	<0.39	4.1	1.8	--	<0.39
PAHs (µg/l)																							
Acenaphthene	NSE	NSE	<0.10	<0.10	<0.10	<0.06	<0.06	<0.06	<0.33	<0.33	<0.33	<0.33	<0.82	<0.33	<0.33	<0.41	<0.33	<0.34	<0.33	<0.33	0.33	0.71	<0.33
Acenaphthylene	NSE	NSE	<0.15	<0.15	<0.15	<0.06	<0.06	<0.06	<0.69	<0.69	<0.69	<0.69	<1.7	<0.69	<0.69	<0.86	<0.69	<0.72	<0.69	<0.70	<0.69	<0.69	<0.69
Anthracene	3,000	600	<0.09	<0.09	<0.09	<0.05	<0.05	<0.09	<0.038	<0.038	<0.038	<0.038	<0.095	<0.038	<0.038	<0.048	<0.038	<0.040	<0.038	0.23	0.26	0.26	0.39
Benzo(a)Anthracene	NSE	NSE	<0.03	<0.03	<0.03	<0.04	<0.04	<0.10	<0.044	<0.044	<0.044	<0.044	<0.11	<0.044	<0.044	<0.055	<0.044	<0.046	<0.044	<0.044	<0.044	<0.044	<0.044
Benzo(a)Pyrene	0.2	0.02	<0.02	<0.02	<0.02	<0.017	<0.017	<0.02	<0.032	<0.032	<0.032	<0.032	<0.080	<0.032	<0.032	<0.040	<0.032	<0.033	<0.032	<0.032	<0.032	<0.032	<0.032
Benzo(b)Fluoranthene	NSE	NSE	<0.02	<0.02	<0.02	<0.04	<0.04	<0.02	<0.049	<0.049	<0.049	<0.049	<0.24	<0.098	<0.098	<0.12	<0.098	<0.10	<0.098	<0.099	<0.049	<0.098	<0.049
Benzo(k)Fluoranthene	NSE	NSE	<0.03	<0.03	0.179	<0.04	<0.04	<0.07	<0.049	<0.049	<0.049	<0.049	<0.12	<0.049	<0.049	<0.061	<0.049	<0.051	<0.049	<0.049	<0.049	<0.049	<0.049
Benzo(g,h,i)Perylene	NSE	NSE	<0.09	<0.09	<0.09	<0.05	<0.05	<0.06	<0.12	<0.12	<0.12	<0.12	<0.30	<0.12	<0.12	<0.15	<0.12	<0.12	<0.12	<0.12	<0.12	<0.12	<0.12
Chrysene	0.2	0.02	<0.02	<0.02	<0.02	<0.05	<0.05	<0.02	<0.041	<0.041	<0.041	<0.041	<0.10	<0.041	<0.041	<0.051	<0.041	<0.043	<0.041	<0.041	<0.041	<0.041	<0.041
Dibenzo(a,h)Anthracene	NSE	NSE	<0.06	<0.06	<0.06	<0.06	<0.06	<0.11	<0.13	<0.13	<0.13	<0.13	<0.32	<0.13	<0.13	<0.16	<0.13	<0.14	<0.13	<0.13	<0.13	<0.13	<0.13
Fluoranthene	400	80	<0.03	<0.03	<0.03	<0.06	<0.06	<0.12	<0.081	<0.081	<0.081	<0.81	<0.20	<0.081	0.13	<0.10	<0.081	<0.084	0.11	<0.082	0.41	<0.081	1.5
Fluorene	400	80	<0.11	<0.11	<0.11	<0.12	<0.12	<0.12	<0.062	<0.062	<0.062	<0.002	<0.16	<0.062	<0.062	<0.078	<0.062	<0.065	<0.062	<0.062	2.2	1.9	1.9
Indeno(1,2,3-cd)Pyrene	NSE	NSE	<0.06	<0.06	<0.06	<0.05	<0.05	<0.12	<0.062	<0.062	<0.062	<0.16	<0.062	<0.062	<0.078	<0.062	<0.065	<0.062	<0.062	<0.063	<0.062	<0.062	<0.062
1-Methyl Naphthalene	NSE	NSE	0.135	<0.13	0.149	<0.08	<0.08	<0.08	<0.32	<0.32	<0.32	<0.32	<0.80	<0.32	<0.32	<0.40	<0.32	<0.33	<0.32	24	14	9	7.5
2-Methyl Naphthalene	NSE	NSE	<0.12	<0.12	<0.12	<0.11	<0.11	<0.11	<0.31	<0.31	<0.31	<0.31	<0.78	<0.31	<0.31	<0.39	<0.31	<0.32	<0.31	29	16	12	10
Naphthalene	100	10	<0.06	<0.06	<0.06	<0.1	<0.1	<0.11	<0.40	<0.40	<0.40	<0.40	<1.0	<0.40	<0.40	<0.50	<0.40	<0.42	<0.40	14	7.5	3.5	3.3
Phenanthrene	NSE	NSE	<0.11	0.165	0.146	<0.08	<0.08	<0.11	<0.03	<0.03	<0.03	<0.03	0.075	<0.03	0.067	0.038	<0.03	<0.031	0.054	1.0	0.86	1.4	1.4
Pyrene	250	50	<0.10	<0.10	<0.12	<0.09	<0.09	<0.10	<0.044	<0.044	<0.044	<0.044	<0.11	<0.044	<0.044	<0.055	<0.044	<0.046	<0.044	<0.044	<0.044	<0.044	0.48
VOCs (µg/l)																							
Benzene	5.0	0.5	--	--	--	--	--	--	--	--	--	--	--	<0.20	--	--	--	<0.20	--	--	--	<0.20	--
Bromobenzene	NSE	NSE	--	--	--	--	--	--	--	--	--	--	--	<0.20	--	--	--	<0.20	--	--	--	<0.20	--
Bromochloromethane	NSE	NSE	--	--	--	--	--	--	--	--	--	--	--	<0.50	--	--	--	<0.50	--	--	--	<0.50	--
Bromodichloromethane	0.6	0.06	--	--	--	--	--	--	--	--	--	--	--	<0.20	--	--	--	<0.20	--	--	--	<0.20	--
Bromoform	4.4	0.44	--	--	--	--	--	--	--	--	--	--	--	<0.20	--	--	--	<0.20	--	--	--	<0.20	--
Bromomethane	10	1.0	--	--	--	--	--	--	--	--	--	--	--	<0.20	--	--	--	<0.20	--	--	--	<0.20	--
n-Butylbenzene	NSE	NSE	--	--	--	--	--	--	--	--	--	--	--	<0.20	--	--	--	<0.20	--	--	--	2.3	--
sec-Butylbenzene	NSE	NSE	--	--	--	--	--	--	--	--	--	--	--	<0.25	--	--	--	<0.25	--	--	--	2.5	--
tert-Butylbenzene	NSE	NSE	--	--	--	--	--	--	--	--	--	--	--	<0.20	--	--	--	<0.20	--	--	--	<0.20	--
Carbon Tetrachloride	5.0	0.5	--	--	--	--	--	--	--	--	--	--	--	<0.50	--	--	--	<0.50	--	--	--	<0.50	--
Chlorobenzene	NSE	NSE	--	--	--	--	--	--	--	--	--	--	--	<0.20	--	--	--	<0.20	--	--	--	<0.20	--
Chlorodibromomethane	NSE	NSE	--	--	--	--	--	--	--	--	--	--	--	<0.20	--	--	--	<0.20	--	--	--	<0.20	--
Chloroethane	400	80	--	--	--	--	--	--	--	--	--	--	--	<1.0	--	--	--	<1.0	--	--	--	<0.20	--
Chloroform	6.0	0.6	--	--	--	--	--	--	--	--	--	--	--	<0.20	--	--	--	<0.20	--	--	--	<0.20	--
Chloromethane	3.0	0.3	--	--	--	--	--	--	--	--	--	--	--	<0.20	--	--	--	<0.20	--	--	--	<0.50	--
2-Chlorotoluene	NSE	NSE	--	--	--	--	--	--	--	--	--	--	--	<0.50	--	--	--	<0.50	--	--	--	<0.20	--
4-Chlorotoluene	NSE	NSE	--	--	--	--	--	--	--	--	--	--	--	<0.20	--	--	--	<0.20	--	--	--	<0.50	--
Dibromochloropropane	0.2	0.02	--	--	--	--	--	--	--	--	--	--	--	<0.50	--	--	--	<0.50	--	--	--	<0.20	--
Dibromomethane	NSE	NSE	--	--	--	--	--	--	--	--	--	--	--	<0.20	--	--	--	<0.20	--	--	--	<0.20	--
1,2-Dibromoethane	0.05	0.005	--	--	--	--	--	--	--	--	--	--	--	<0.20	--	--	--	<0.20	--	--	--	<0.20	--
1,1-Dichloroethane	850	85	--	--	--	--	--	--	--	--	--	--	--	<0.50	--	--	--	<0.50	--	--	--	<0.50	--

Danbury Generating Facility – AOC #1
Table 2 – Groundwater Analytical Results

Monitoring Well/Drinking Water Well Groundwater Analytical Results - Turbine Plant

Analytical Parameters	NR 140 Standards		Well No./Sampling Date																					
			TW-1	TW-2	TW-3	Turbine Well				TP-MW-1				TP-MW-2				TP-MW-3						
	ES	PAL	11/01/00	11/01/00	11/01/00	12/05/01	12/15/02	12/08/03	12/17/04	12/19/05	12/12/06	12/13/06	03/13/07	06/11/07	10/01/07	12/13/06	03/13/07	06/11/07	10/01/07	12/14/06	03/13/07	06/11/07	10/01/07	
VOCs (µg/l)																								
1,2-Dichloroethane	5.0	0.5	--	--	--	--	--	--	--	--	--	--	--	<0.50	--	--	--	<0.50	--	--	--	<0.50	--	
1,2-Dichlorobenzene	600	60	--	--	--	--	--	--	--	--	--	--	--	<0.20	--	--	--	<0.20	--	--	--	<0.20	--	
1,3-Dichlorobenzene	1,250	125	--	--	--	--	--	--	--	--	--	--	--	<0.20	--	--	--	<0.20	--	--	--	<0.20	--	
1,4-Dichlorobenzene	75	15	--	--	--	--	--	--	--	--	--	--	--	<0.20	--	--	--	<0.20	--	--	--	<0.20	--	
Dichlorodifluoromethane	1,000	200	--	--	--	--	--	--	--	--	--	--	--	<0.50	--	--	--	<0.50	--	--	--	<0.50	--	
1,1-Dichloroethylene	7.0	0.7	--	--	--	--	--	--	--	--	--	--	--	<0.50	--	--	--	<0.50	--	--	--	<0.50	--	
cis-1,2-Dichloroethylene	70	7.0	--	--	--	--	--	--	--	--	--	--	--	<0.50	--	--	--	<0.50	--	--	--	<0.50	--	
trans-1,2-Dichloroethylene	100	20	--	--	--	--	--	--	--	--	--	--	--	<0.50	--	--	--	<0.50	--	--	--	<0.50	--	
1,2-Dichloropropane	5.0	0.5	--	--	--	--	--	--	--	--	--	--	--	<0.50	--	--	--	<0.50	--	--	--	<0.50	--	
1,3-Dichloropropane	NSE	NSE	--	--	--	--	--	--	--	--	--	--	--	<0.25	--	--	--	<0.25	--	--	--	<0.25	--	
2,2-Dichloropropane	NSE	NSE	--	--	--	--	--	--	--	--	--	--	--	<0.50	--	--	--	<0.50	--	--	--	<0.50	--	
1,1-Dichloropropene	NSE	NSE	--	--	--	--	--	--	--	--	--	--	--	<0.50	--	--	--	<0.50	--	--	--	<0.50	--	
2,3-Dichloropropene	NSE	NSE	--	--	--	--	--	--	--	--	--	--	--	<0.25	--	--	--	<0.25	--	--	--	<0.25	--	
cis-1,3-Dichloropropene	0.20	0.02	--	--	--	--	--	--	--	--	--	--	--	<0.20	--	--	--	<0.20	--	--	--	<0.20	--	
trans-1,3-Dichloropropene	0.20	0.02	--	--	--	--	--	--	--	--	--	--	--	<0.20	--	--	--	<0.20	--	--	--	<0.20	--	
Ethylbenzene	700	140	--	--	--	--	--	--	--	--	--	--	--	<0.50	--	--	--	<0.50	--	--	--	0.9	--	
Hexachlorobutadiene	NSE	NSE	--	--	--	--	--	--	--	--	--	--	--	<0.50	--	--	--	<0.50	--	--	--	<0.50	--	
Isopropyl Ether	NSE	NSE	--	--	--	--	--	--	--	--	--	--	--	<0.50	--	--	--	<0.50	--	--	--	<0.50	--	
Isopropylbenzene	NSE	NSE	--	--	--	--	--	--	--	--	--	--	--	<0.20	--	--	--	<0.20	--	--	--	1.2	--	
p-Isopropyltoluene	NSE	NSE	--	--	--	--	--	--	--	--	--	--	--	<0.20	--	--	--	<0.20	--	--	--	1.0	--	
Methyl tert Butyl Ether	60	12	--	--	--	--	--	--	--	--	--	--	--	<0.50	--	--	--	<0.50	--	--	--	<0.50	--	
Methylene Chloride	5.0	0.5	--	--	--	--	--	--	--	--	--	--	--	<1.0	--	--	--	<1.0	--	--	--	<1.0	--	
Naphthalene	100	10	--	--	--	--	--	--	--	--	--	--	--	<0.25	--	--	--	<0.25	--	--	--	6.9	--	
n-Propylbenzene	NSE	NSE	--	--	--	--	--	--	--	--	--	--	--	<0.50	--	--	--	<0.50	--	--	--	2.8	--	
Styrene	100	10	--	--	--	--	--	--	--	--	--	--	--	<0.20	--	--	--	<0.20	--	--	--	<0.20	--	
1,1,1,2-Tetrachloroethane	70	7.0	--	--	--	--	--	--	--	--	--	--	--	<0.25	--	--	--	<0.25	--	--	--	<0.25	--	
1,1,2,2-Tetrachloroethane	0.2	0.02	--	--	--	--	--	--	--	--	--	--	--	<0.20	--	--	--	<0.20	--	--	--	<0.20	--	
Tetrachloroethylene	5.0	0.5	--	--	--	--	--	--	--	--	--	--	--	<0.50	--	--	--	<0.50	--	--	--	<0.50	--	
Toluene	1,000	200	--	--	--	--	--	--	--	--	--	--	--	<0.20	--	--	--	<0.20	--	--	--	<0.20	--	
Total Trimethylbenzenes	480	96	--	--	--	--	--	--	--	--	--	--	--	<0.40	--	--	--	<0.40	--	--	--	8.58	--	
Total Xylenes	10,000	1,000	--	--	--	--	--	--	--	--	--	--	--	<0.50	--	--	--	<0.50	--	--	--	0.61	--	
1,2,3-Trichlorobenzene	NSE	NSE	--	--	--	--	--	--	--	--	--	--	--	<0.25	--	--	--	<0.25	--	--	--	<0.25	--	
1,2,4-Trichlorobenzene	70	14	--	--	--	--	--	--	--	--	--	--	--	<0.25	--	--	--	<0.25	--	--	--	<0.25	--	
1,1,1-Trichloroethane	200	40	--	--	--	--	--	--	--	--	--	--	--	<0.50	--	--	--	<0.50	--	--	--	<0.50	--	
1,1,2-Trichloroethane	5.0	0.5	--	--	--	--	--	--	--	--	--	--	--	<0.25	--	--	--	<0.25	--	--	--	<0.25	--	
Trichloroethylene	5.0	0.5	--	--	--	--	--	--	--	--	--	--	--	<0.20	--	--	--	<0.20	--	--	--	<0.20	--	
Trichlorofluoromethane	NSE	NSE	--	--	--	--	--	--	--	--	--	--	--	<0.50	--	--	--	<0.50	--	--	--	<0.50	--	
1,2,3-Trichloropropane	60	12	--	--	--	--	--	--	--	--	--	--	--	<0.50	--	--	--	<0.50	--	--	--	<0.50	--	
Vinyl Chloride	0.2	0.02	--	--	--	--	--	--	--	--	--	--	--	<0.20	--	--	--	<0.20	--	--	--	<0.20	--	

NSE = No standard established
ES = ch. NR 140 Enforcement Standard (ES)
PAL = ch. NR 140 Preventive Action Limit (PAL)
14 = Exceeds ch. NR 140 PAL
µg/l = micrograms per liter (ppb)
Compiled by: BLK Checked by: DRR

P:\KON\Nwec\070200\Reports&Specs\misc\Mon Well GW Results-Turbine Plant.xls

Danbury Generating Facility – AOC #1
 Table 2 – Groundwater Analytical Results

Hydraulic Push Groundwater Analytical Results - Turbine Plant

Analytical Parameters	NR 140 Standards		Hydraulic Push Sample No./Sample Interval (feet below ground)/Sampling Date										
			TP-1	TP-2	TP-3	TP-5	TP-6	TP-7	TP-8	TP-9	TP-10	TP-11	TP-12
	ES	PAL	5-10 11/15/06										
PVOCs (µg/l)													
Benzene	5.0	0.5	<0.50	1.6	<0.25	<0.5	<0.25	<0.5	<10	<0.50	<0.25	<0.25	<0.25
Ethylbenzene	700	140	<0.44	<0.44	1.7	<0.44	<0.22	0.86	44	1.5	<0.22	<0.22	<0.22
Methyl tert butyl ether	60	12	<0.46	<0.46	<0.23	<0.46	<0.23	<0.46	<9.2	<0.46	<0.23	<0.23	<0.23
Toluene	1,000	200	0.30	0.34	0.27	0.48	0.29	0.24	<4.4	0.30	0.21	0.13	0.21
Total Trimethylbenzenes	480	96	<0.88	<1.0	50	<0.88	<0.44	4.3	1,400	<0.88	<0.44	<0.44	<0.44
Total Xylenes	10,000	1,000	<0.78	<0.78	3.2	<0.78	<0.39	0.82	74	<0.78	<0.39	0.63	<0.39
PAHs (µg/l)													
Naphthalene	100	10	<1.0	<1.0	11	<1.0	<0.50	5.6	380	6.0	<0.5	3.6	<0.50

1,400 = Exceeds ch. NR 140 Enforcement Standard (ES)
1.6 = Exceeds ch. NR 140 Preventive Action Limit (PAL)
 µg/l = micrograms per liter (ppb)
 Compiled by: DRR Checked by: XXX

P:\KO\N\Nwec\070200\Reports&Specs\misc\Hyd Push GW Results-Turbine Plant.xls

Danbury Generating Facility – AOC #1
Table 3 – Water Table Elevations

Turbine Plant Well	Wisconsin Unique Well Number	Date	Well Depth from TPVC (ft)	Top PVC (ft)	Depth to Groundwater (ft)	Elevation Groundwater (ft)
Permanent Wells						
TP-MW-1	PH973	12/13/06	9.8	937.38	6.30	931.08
TP-MW-2	PH974	12/13/06	6.30	934.47	3.37	931.10
TP-MW-3	PH975	12/14/06	7.40	934.51	4.45	930.06
TP-MW-1	PH973	3/13/07	9.8	937.38	6.45	930.93
TP-MW-2	PH974	3/13/07	6.30	934.47	3.55	930.92
TP-MW-3	PH975	3/13/07	7.40	934.51	3.72	930.79
TP-MW-1	PH973	6/11/07	9.8	937.38	4.72	932.66
TP-MW-2	PH974	6/11/07	6.30	934.47	2.71	931.76
TP-MW-3	PH975	6/11/07	7.40	934.51	3.11	931.40
TP-MW-1	PH973	10/1/07	9.8	937.38	6.1	931.28
TP-MW-2	PH974	10/1/07	6.30	934.47	3.18	931.29
TP-MW-3	PH975	10/1/07	7.40	934.51	3.35	931.16
Compiled by: <u>DRR</u> Checked by: <u>BLK</u>						

Q:\KOV\wwec\990200\Reports&Specs\misc\gw elevation data-danbury.xls