

GIS REGISTRY INFORMATION

SITE NAME:	Town Of Wien Garage		FID #	
BRRTS #:	03-37-000608		(if appropriate):	
COMMERCE # (if appropriate):	54226-9604-90			
CLOSURE DATE:	April 14, 2004			
STREET ADDRESS:	W4290 County Rd M			
CITY:	Edgar			

SOURCE PROPERTY GPS COORDINATES (meters in WTM91 projection):	X = 517966 518000	Y = 491961 492005
---	-------------------	-------------------

CONTAMINATED MEDIA:	Groundwater		Soil	<input checked="" type="checkbox"/>	Both	
OFF-SOURCE GW CONTAMINATION >ES:	Yes		No		X	

• IF YES, STREET ADDRESS:

GPS COORDINATES (meters in WTM91 projection):	X =	Y =
---	-----	-----

OFF-SOURCE SOIL CONTAMINATION >Generic or Site-Specific RCL (SSRCL):	Yes		No	X
--	-----	--	----	---

• IF YES, STREET ADDRESS 1:

GPS COORDINATES (meters in WTM91 projection):	X =	Y =
---	-----	-----

CONTAMINATION IN RIGHT OF WAY:	Yes		No	X
---------------------------------------	-----	--	----	---

DOCUMENTS NEEDED

Closure Letter, and any conditional closure letter issued	X
Copy of most recent deed, including legal description, for all affected properties	X
Certified survey map or relevant portion of the recorded plat map (if referenced in the legal description) for all affected properties	X
County Parcel ID number, if used for county, for all affected properties	X
Location Map which outlines all properties within contaminated site boundaries on USGS topographic map or plat map in sufficient detail to permit the parcels to be located easily (8.5x14" if paper copy). If groundwater standards are exceeded, the map must also include the location of all municipal and potable wells within 1200' of the site.	X
Detailed Site Map(s) for all affected properties , showing buildings, roads, property boundaries, contaminant sources, utility lines, monitoring wells and potable wells. (8.5x14", if paper copy) This map shall also show the location of all contaminated public streets, highway and railroad rights-of-way in relation to the source property and in relation to the boundaries of groundwater contamination exceeding ch. NR 140 ESs and soil contamination exceeding ch. NR 720 generic or SSRCLs.	X
Tables of Latest Groundwater Analytical Results (no shading or cross-hatching)	X
Tables of Latest Soil Analytical Results (no shading or cross-hatching)	X
Isoconcentration map(s), if required for site investigation (SI) (8.5x14" if paper copy). The isoconcentration map should have flow direction and extent of groundwater contamination defined. If not available, include the latest extent of contaminant plume map.	X
GW: Table of water level elevations, with sampling dates, and free product noted if present	X
GW: Latest groundwater flow direction/monitoring well location map (should be 2 maps if maximum variation in flow direction is greater than 20 degrees)	X
SOIL: Latest horizontal extent of contamination exceeding generic or SSRCLs, with one contour	X
Geologic cross-sections, if required for SI. (8.5x14" if paper copy)	X
RP certified statement that legal descriptions are complete and accurate.	X
Copies of off-source notification letters (if applicable)	X
Letter informing ROW owner of residual contamination (if applicable)(public, highway or railroad ROW)	X
Copy of (soil or land use) deed restriction (s) or deed notice if any required as a condition of closure	X



ENVIRONMENTAL & REGULATORY SERVICES DIVISION
BUREAU OF PECFA
2715 Post Road
Stevens Point, Wisconsin 54481-
TDD #: (608) 264-8777
Fax #: (715) 345-5269
Jim Doyle, Governor
Cory L. Nettles, Secretary

April 14, 2004

Lowell Borchardt
Town of Wien
W4311 Wien Dr
Edgar, WI 54426

RE: **Final Closure**

Commerce # 54226-9604-90 **WDNR BRRTS # 03-37-000608**
Town Of Wien Garage, W4290 County Rd M, Edgar

Dear Mr. Borchardt:

The Wisconsin Department of Commerce (Commerce) has received all items required as conditions for closure of the site referenced above. This case is now listed as "closed" on the Commerce database and will be included on the Wisconsin Department of Natural Resources (WDNR) Geographic Information System (GIS) Registry of Closed Remediation Sites to address residual contamination. It is in your best interest to keep all documentation related to the environmental activities that were conducted.

If residual contamination is encountered in the future, it must be managed in accordance with all applicable state and federal regulations. If it is determined that any remaining contamination poses a threat, the case may be reopened and further investigation or remediation may be required.

Thank you for your efforts to bring this case to closure. If you have any questions, please contact me in writing at the letterhead address or by telephone at (715) 342-3802.

Sincerely,

A handwritten signature in black ink, appearing to read "Dee Zoellner". The signature is fluid and cursive, written over a white background.

Dee Zoellner
Hydrogeologist
Site Review Section

cc: Tim Giles, Earth Tech Inc
Case File



July 25, 2003

Lowell Borchardt
Town Of Wien
W3927 County Road M
Edgar, WI 54426

RE: **Conditional Case Closure**

Commerce # 54226-9604-90 WDNR BRRTS # 03-37-000608
Town Of Wien Garage, W4290 Hwy M, Edgar

UST: 400 Gallon Diesel

Dear Mr. Borchardt:

The Wisconsin Department of Commerce (Commerce) has reviewed the request for case closure prepared by your consultant, Earth Tech Inc, for the site referenced above. It is understood that residual soil contamination remains on-site. Commerce has determined that this site does not pose a significant threat to the environment and human health. No further investigation or remedial action is necessary.

The following conditions must be satisfied to obtain final closure:

- All monitoring wells (MW-1, MW-2R, MW-3 & MW-4) must be properly abandoned. The appropriate documentation must be forwarded to the letterhead address.

This letter serves as your written notice of "no further action". Timely filing of your final PECFA claim (if applicable) is encouraged. If your claim is not received within 120 days of the date of this letter, interest costs incurred after 60 days of the date of this letter will not be eligible for PECFA reimbursement.

Thank you for your efforts to protect Wisconsin's environment. If you have any questions, please contact me in writing at the letterhead address or by telephone at (715) 342-3802.

Sincerely,

Dee Zoellner
Hydrogeologist
Site Review Section

cc: Tim Giles, Earth Tech Inc
Case File

Number.

4717B

This Indenture, Made this 9th day of Sept, in the year of our Lord, one thousand eight hundred and ninety five between D. H. Johnson and Electa A. Johnson his wife Fred Rietbrock, Helen M. Rietbrock his wife and L. W. Halsey & Mary L. Halsey his wife all of Madison Wis part 1st of the first part, and The Town of Wisconsin of Marathon County; part 1 of the second part,

Witnesseth, That the said part 1st of the first part, for and in consideration of the sum of Five Dollars,

to them in hand paid by the said part 1 of the second part, the receipt whereof is hereby confessed and acknowledged, have given, granted, bargained, sold, remised, released, aliened, conveyed and confirmed, and by these presents do give, grant, bargain, sell, remise, release, alien, convey and confirm unto the said part 1 of the second part, the Successors heirs and assigns forever, the following described real estate situated in the County of Marathon and State of Wisconsin, to-wit:

A piece of land in the Northeast corner of the Northeast quarter (NE 1/4) of the Northeast quarter (NE 1/4) of Section Twenty one (21) in Township Twenty eight (28) North of Range Four (4) East described as follows: commencing at the monument of the Northeast corner of said Section, running thence South on Section line between Sections 21 and 22, Thirteen (13) rods thence West Twelve (12) rods, thence North Thirteen (13) rods, to the North line of said Section 21, thence East along said North line Twelve (12) rods to the point of commencement containing one acre of land more or less.

TOGETHER with all and singular the hereditaments and appurtenances thereunto belonging or in any wise appertaining; and all the estate, right, title, interest, claim or demand whatsoever, of the said part 1st of the first part, either in law or equity, either in possession or expectancy of, in and to the above bargained premises, and their hereditaments and appurtenances.

TO HAVE AND TO HOLD the said premises as above described, with the hereditaments and appurtenances, unto the said part 1 of the second part, and to the Successors heirs and assigns forever.

AND THE SAID D. H. Johnson, Fred Rietbrock & L. W. Halsey for themselves and their heirs, executors and administrators, do covenant, grant, bargain and agree to and with the said part 1 of the second part, the Successors heirs and assigns, that at the time of the ensembling and delivery of these presents they are well seized of the premises above described, as of a good, sure, perfect, absolute and indefeasible estate of inheritance in the law, in fee simple, and that the same are free and clear from all incumbrances whatever.

and that the above bargained premises in the quiet and peaceable possession of the said part 1 of the second part, the Successors heirs and assigns, against all and every person or persons lawfully claiming the whole or any part thereof, they will forever warrant and defend.

IN WITNESS WHEREOF, the said part 1st of the first part have hereunto set their hand and seals this 9th day of the date hereof A. D. 1895

Signed, Sealed and Delivered in Presence of
W. P. Kimmey
Charles J. Aberg

D. H. Johnson [SEAL]
Electa A. Johnson [SEAL]
Fred Rietbrock [SEAL]
Helen M. Rietbrock [SEAL]
L. W. Halsey [SEAL]
Mary L. Halsey [SEAL]

STATE OF WISCONSIN,
Madison COUNTY. } ss.

Personally came before me, this 31st day of September

This Indenture Made by Joint School District #6 of the Village of Edgar and Fenwood and Towns of Cassell, Cleveland, Emmett, Frankfort, Rib Falls, Rietbrock and Wien School District, a Corporation duly organized and existing under and by

virtue of the laws of the State of Wisconsin, grantor, of Marathon County, Wisconsin, hereby conveys unto Town of Wien, a political subdivision of the State of Wisconsin

grantee, of Marathon County, Wisconsin, for the sum of One Dollar and other good and valuable consideration

the following tract of land in Marathon County, State of Wisconsin:

One acre of land 13 rods from North to South and Twelve rods 5 1/2 feet from East to West, being the Southeast corner of the South half Southeast quarter of Section 16, Township 28 North, Range 4 East.

pass-2/8



This deed is given pursuant to authority granted by annual school meeting and resolution adopted by the Board on the 10th day of August, 1964.

In witness whereof, the said grantor has caused these presents to be signed by

Herman A. Schulz, its President and countersigned by Clifford Kolpack, its Secretary, at Edgar, Wisconsin, and its

corporate seal to be hereto affixed, this 24th day of September, A. D., 1964, Joint School Dist. #6 of the Village of Edgar, at al.

Signed and Sealed in Presence of

[Signature of N. D. Kleinstick]

N. D. Kleinstick

[Signature of Dave E. Myska]

Dave E. Myska

[Signature of Herman A. Schulz]

Corporate Name
Herman A. Schulz
President

Countersigned:
Clifford Kolpack
Clerk

[Signature of Clifford Kolpack]

State of Wisconsin, Marathon County, ss.

Personally came before me this 24th day of September, A. D., 1964, Herman A. Schulz, President, and Clifford Kolpack, Clerk Secretary

of the above named Corporation, to me known to be the persons who executed the foregoing instrument, and to me known to be such President and Secretary of said Corporation, and acknowledged that they executed the foregoing instrument as such officers as the deed of said Corporation, by its authority.



REC'D FOR RECORD

Oct 27 1964

Earl W. Netzel
Register of Deeds

R. E. Meyer

Notary Public, Marathon County, Wis.

My Commission expires

My Commission Expires Oct 15, 1967

Robert C. Altman-Attorney at Law

Lowell M. Borchardt and Audrey C. Borchardt,
husband and wife as joint tenants

conveys and warrants to the Town of Wein

VOLUME 695 OF MICRO
RECORDS ON PAGE 1331

Michael J. Sydow

RETURN TO
Trusty, Hittner, Kennedy
& Freeburg

the following described real estate in Marathon County,
State of Wisconsin:

CE 10.00 YR. CE 3.00

Lot one (1) of Certified Survey Map No. 8177
recorded in the office of the Register of Deeds
for Marathon County, Wisconsin, in Volume 31 of Certified
Survey Maps on page 130; being a part of the Southeast quarter
(SE $\frac{1}{4}$) of the Southeast quarter (SE $\frac{1}{4}$) of Section sixteen (16), Township
twenty-eight (28) North, Range four (4) East, in the Town of Wein,
Marathon County, Wisconsin excepting that part previously conveyed in
a deed dated September 24, 1964 and recorded in Volume 498 of Micro-
Records on page 477 of Marathon County Register of Deeds. Grantor shall
be responsible for all 1994 real estate taxes.

Tax Parcel No: 42-162804-16.2

PIN: 37-084-4-2804-164-0995

TRANSFER

\$ 3.⁰²
FEE

This is not..... homestead property.
(is) (is not)

Exception to warranties:

Dated this 19 day of December, 1994

(SEAL)

Lowell M. Borchardt (SEAL)

Lowell M. Borchardt

(SEAL)

Audrey C. Borchardt (SEAL)

Audrey C. Borchardt

AUTHENTICATION

ACKNOWLEDGMENT

Signature(s)

STATE OF WISCONSIN

authenticated this day of


Marathon County, Wis.

Personally came before me this 19th day of
December, 19⁹⁴ the above named

Lowell M. Borchardt and Audrey C.
Borchardt

TITLE: MEMBER STATE BAR OF WISCONSIN

(If not, authorized by § 706.06, Wis. Stat.)

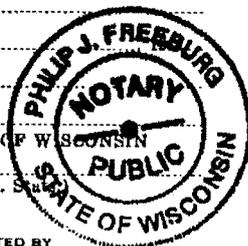

REC'D FOR RECORDS

Michael J. Sydow

to me known to be the person who executed the
foregoing instrument and acknowledge ~~DECLARED~~ 1994

THIS INSTRUMENT WAS DRAFTED BY

Trusty, Hittner, Kennedy & Freeburg, S.C.

PHILIP J. FREEBURG
Notary Public Marathon County, Wis.
My Commission is permanent. (If not, state expiration
date:, 19.....)


(Signatures may be authenticated or acknowledged. Both
are not necessary.)

*Names of persons signing in any capacity should be typed or printed below their signatures.

8177


37.084.4.2804.164.0995

MARATHON COUNTY CERTIFIED SURVEY MAP
PART OF SE 1/4, SE 1/4, SECTION 16, T28N, R4E,
TOWN OF WIEN

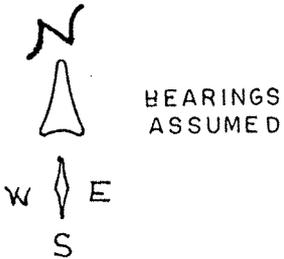


BEARINGS
ASSUMED

SCALE

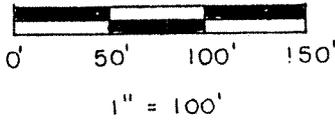


LEGEND

● = 1" X 24" IRON PIN SET

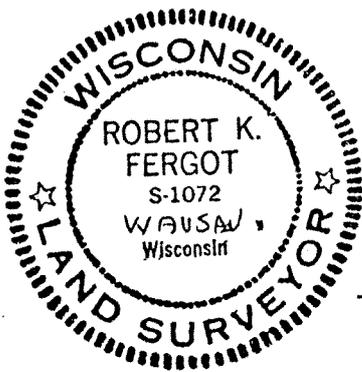

Robert K. Fergot
Robert K., Fergot
August 5, 1994

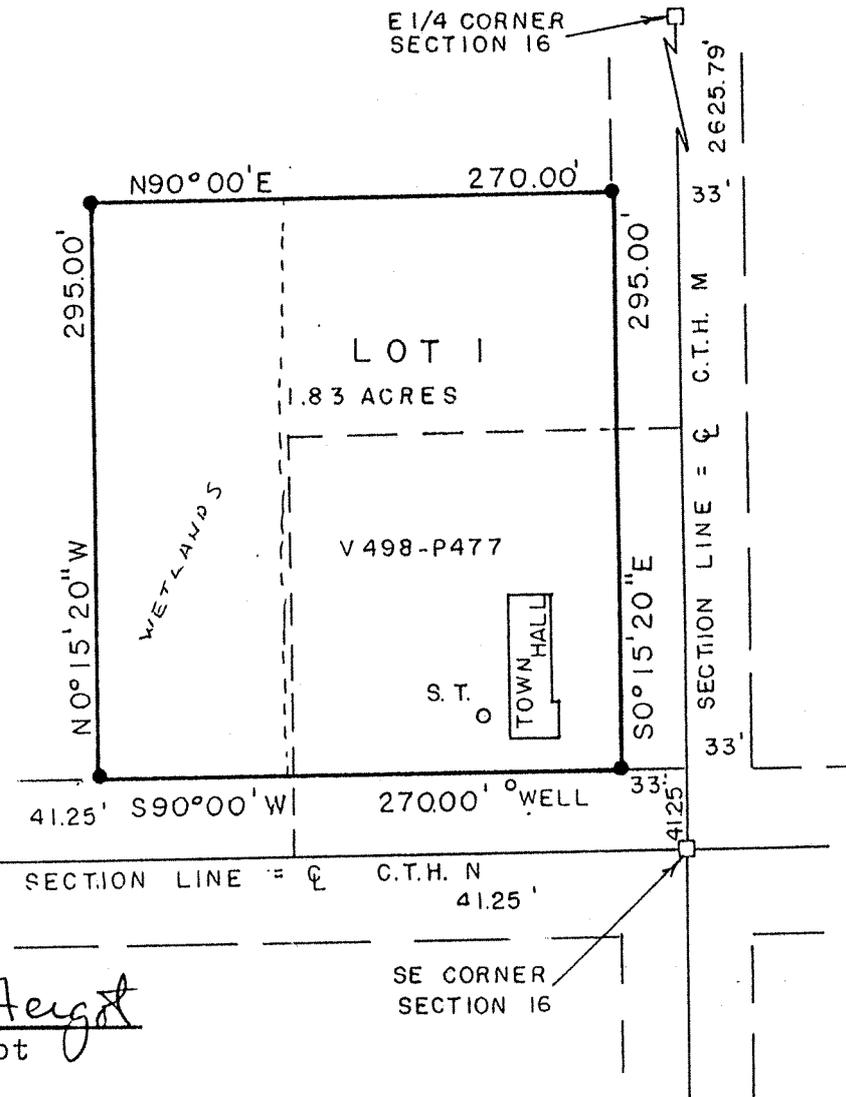

SURVEYORS CERTIFICATE

I, Robert K. Fergot, Registered Land Surveyor, hereby certify that I have surveyed, divided and mapped said parcel at the direction of Clarence Miessner, chairman of the Town of Wien, that said map correctly represents the boundaries of the land surveyed, and that said survey is in full compliance with chapter 236.34 of the Wisconsin Statutes and local codes and ordinances, and that said lands are located all within the SE 1/4 of the SE 1/4 of Section 16, T28N, R4E, Town of Wien and are more particularly described as follows:

Commencing at the SE Corner of said Section 16 and running thence N0°15'20"W 41.25 feet; thence S90°00'W 33.00 feet to the point of beginning; thence continue S90°00'W 270.00 feet; thence N0°15'20"W



INDEX MAP

MARATHON COUNTY

R 4 E





T 28 N

W I E N

SITE

SOURCE: USGS 7.5 MINUTE QUADRANGLE, WIEN, WISCONSIN, 1982

SCALE 1:24000

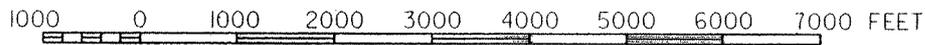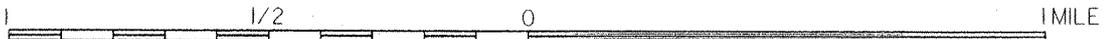

CONTOUR INTERVAL 10 FEET
DATUM IS MEAN SEA LEVEL

EARTH TECH



FIGURE 1
SITE LOCATION MAP
FORMER UST SITE
TOWN OF WIEN GARAGE
MARATHON COUNTY, WISCONSIN

AUGUST 2002

41590

\$\$\$RFO3\$\$
\$\$\$RFO3\$\$
\$\$\$RFO4\$\$
\$\$\$RFO4\$\$

\$\$\$RFO1\$\$
\$\$\$RFO1\$\$
\$\$\$RFO2\$\$
\$\$\$RFO2\$\$

\$\$\$USER\$\$
\$\$\$LEVEL\$\$
\$\$\$PRF\$\$
\$\$\$DATE\$\$

REFERENCE FILE 01 = L:\work\Projects\41590\gra\8511p.dgn
 Levels = 1-63
 REFERENCE FILE 02 = L:\work\Projects\41590\gra\site.dgn
 Levels = 1,2,4-63

User is TKuhn83072
 Levels are 1,2,4-63
 PRF = L:\work\Projects\41590\gra\fig2.prf
 DATE= Thu Aug 1 09:37:47 2002

COUNTY TRUNK HIGHWAY "N"

GRASS

GRASS


POWER POLE
(TYP.)

GRAVEL

COUNTY TRUNK HIGHWAY "M"

DITCH

AREA WHERE
POTENTIALLY
IMPACTED SOIL
MAY HAVE BEEN
LEFT IN PLACE

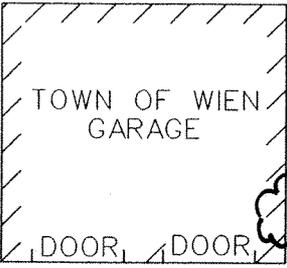

APPROXIMATE LOCATION OF
FORMER 400 GALLON UST

MW-1

MW-2R

CULVERT

GRAVEL

NOTES: 1. MW-1 WAS INSTALLED
AS A PIEZOMETER


MW-4

MW-3

POWER POLE

WOODED AREA

GRASS

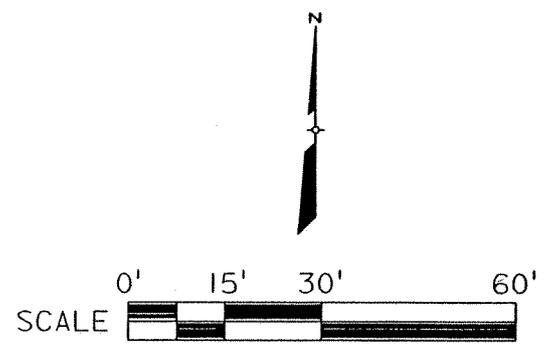

GPS COORDINATES

44° 54' 05.6"

90° 01' 30.9"

LEGEND

MW-1 MONITORING WELL LOCATION



FIGURE 2
 SITE MAP
 FORMER UST SITE
 TOWN OF WIEN GARAGE
 MARATHON COUNTY, WISCONSIN

AUGUST 2002

41590

**TABLE 1
GROUNDWATER SAMPLE ANALYTICAL RESULTS
FORMER UST SITE
TOWN OF WEIN GARAGE
MARATHON COUNTY, WISCONSIN**

Sample Location:			MW-1				MW-1 Dup.			MW-2		MW-2R	
Date:			12/11/91	04/01/96	08/11/00	11/22/02	12/11/91	04/01/96	08/11/00	02/17/92	04/01/96	08/11/00	11/22/02
Parameter (units)	NR 140 ES	NR 140 PAL											
TPH - Diesel (mg/l)	No Std	No Std	0.2	--	--	--	<0.14	--	--	<0.14	--	--	
DRO (µg/L)	No Std	No Std	--	<100	--	--	--	<100	--	--	<100	--	
VOCs/PVOCs (µg/L)													
Cumene	No Std	No Std	<0.3	--	--	--	<0.3	--	--	0.3	--	--	
1,4-Dichlorobenzene	75	15	<0.2	<1.0	--	--	<0.2	<1.0	--	<0.2	<1.0	--	
Methylene Chloride	5	0.5	<0.2	<1.0	--	--	<0.2	<1.0	--	<0.2	<1.0	--	
Toluene	1,000	200	46.7	<1.0	<0.4	<0.3	42.2	<1.0	<0.4	100	<1.0	<0.4	
Trimethylbenzenes	480	96	<0.5	<2.0	<0.55	<0.71	<0.5	<2.0	<0.55	<1.1	<2.0	<0.55	
Xylenes	10,000	1,000	<0.7	<2.0	<0.55	<0.92	<0.7	<2.0	<0.55	1.3	<2.0	<0.55	
Dissolved Lead	15	1.5	--	--	1.48	--	--	--	1.48	--	--	2.23	
Field Screening													
Dissolved Oxygen			--	--	0.27	--	--	--	--	--	--	1.18	
Redox Potential (ORP)			--	--	-4	--	--	--	--	--	--	126	

Notes:

mg/l = Milligrams per liter

µg/L = Micrograms per liter

PVOCs = Petroleum Volatile Organic Compounds

VOCs = Volatile Organic Compounds

ES = Enforcement Standard identified in Chapter NR 140, Wisconsin Administrative Code

PAL = Preventive Action Limit identified in Chapter NR 14, Wisconsin Administrative Code

No Std = No Standard

-- = Not analyzed

* = Estimated concentration below laboratory quantitation level

** = Probable lab artifact

Dup. = Duplicate sample

1. Only PVOCs/VOCs which were detected above laboratory detection limits are listed on this table.
2. No analytes detected exceeded ESs.
3. Bolding and shading indicate exceedence of PAL.
4. Supply well is located on Town Hall property, directly north of the Garage site (north side of CTH N).

TABLE 1 (cont.)															
Sample Location:			MW-3		MW-4		MW-4 Dup.	Supply Well		Field Blank	Trip Blank				
Date:			08/11/00	11/22/02	08/11/00	11/22/02	11/22/02	12/11/91	11/22/02	12/11/91	12/11/91	02/17/92	04/01/96	08/11/00	11/22/02
Parameter (units)	NR 140 ES	NR 140 PAL													
TPH - Diesel (mg/l)	No Std	No Std	--	--	--	--	--	--	--	--	--	--	--	--	--
DRO (µg/L)	No Std	No Std	--	--	--	--	--	--	--	--	--	--	--	--	--
VOCs/PVOCs (µg/L)															
Cumene	No Std	No Std	--	--	--	--	--	<0.3	--	<0.3	<0.3	<0.3	--	--	--
1,4-Dichlorobenzene	75	15	--	--	--	--	--	<0.2	--	<0.2	<0.2	0.4	<1.0	--	--
Methylene Chloride	5	0.5	--	--	--	--	--	<0.2	--	<0.2	<0.2	0.5**	<1.0	--	--
Toluene	1,000	200	<0.4	<0.3	<0.4	<0.3	<0.3	<0.1	<0.3	<0.1	<0.1	0.5	<1.0	<0.4	<0.3
Trimethylbenzenes	480	96	<0.55	<0.71	<0.55	<0.71	<0.71	<0.5	<0.71	<0.5	<0.5	<0.5	<2.0	<0.55	<0.71
Xylenes	10,000	1,000	<0.55	<0.92	<0.55	<0.92	<0.92	<0.7	<0.92	<0.7	<0.7	<0.7	<2.0	<0.55	<0.92
Dissolved Lead	15	1.5	3.10*	--	<1.00	--	--	--	--	--	--	--	--	--	--
Field Screening															
Dissolved Oxygen			3.05	--	0.76	--	--	--	--	--	--	--	--	--	--
Redox Potential (ORP)			97	--	138	--	--	--	--	--	--	--	--	--	--

Notes:

mg/l = Milligrams per liter

µg/L = Micrograms per liter

PVOCs = Petroleum Volatile Organic Compounds

VOCs = Volatile Organic Compounds

ES = Enforcement Standard identified in Chapter NR 140, Wisconsin Administrative Code

PAL = Preventive Action Limit identified in Chapter NR 14, Wisconsin Administrative Code

No Std = No Standard

-- = Not analyzed

* = Estimated concentration below laboratory quantitation level

** = Probable lab artifact

Dup. = Duplicate sample

1. Only PVOCs/VOCs which were detected above laboratory detection limits are listed on this table.
2. No analytes detected exceeded ESs.
3. Bolding and shading indicate exceedence of PAL.
4. Supply well is located on Town Hall property, directly north of the Garage site (north side of CTH N).

TABLE 4-1
 SOIL SAMPLE ANALYTICAL RESULTS
 TOWN OF WIEN
 MARATHON COUNTY, WISCONSIN

<u>Boring</u>	<u>Sample Interval (feet)</u>	<u>% Total Solids</u>	<u>TPH (Diesel) (mg/kg)</u>	<u>Benzene (mg/kg)</u>	<u>Ethylbenzene (mg/kg)</u>	<u>Toluene (mg/kg)</u>	<u>Total Xylenes (mg/kg)</u>	<u>MTBE (mg/kg)</u>	<u>1,2,4-TMB (mg/kg)</u>	<u>1,3,5-TMB (mg/kg)</u>
B1	5.0 - 6.2	81.7	11,930	<0.03	0.36	<0.04	0.35	<0.04	2.3	1.0
B2	5.0 - 6.5	85.2	176	<0.03	<0.02	<0.04	<0.04	<0.04	0.15	<0.03
B3	6.0 - 6.5	84.9	<7	<0.04	<0.02	<0.04	<0.05	<0.05	<0.04	<0.04
B4	6.5 - 7.0	83.2	<7	<0.03	<0.02	<0.04	<0.05	<0.04	<0.03	<0.03
B5	5.5 - 7.0	83.9	16	<0.04	<0.02	<0.04	<0.05	<0.05	<0.04	<0.04
B6	6.0 - 7.0	86.5	<7	<0.03	<0.02	<0.04	<0.05	<0.04	<0.03	<0.03
B7	10.0 - 11.0	83.3	<7	<0.03	<0.02	<0.04	<0.04	<0.04	<0.03	<0.03
B7	14.5 - 16.0	88.1	<7	<0.03	<0.02	<0.03	<0.04	<0.03	<0.03	<0.03
B7	16.0 - 17.5	82.4	<7	<0.03	<0.02	<0.04	<0.05	<0.04	<0.03	<0.03
MW-2	7.0 - 8.0	87.7	<7	NP	NP	NP	NP	NP	NP	NP

Notes:

1,2,4-TMB = 1,2,4-Trimethylbenzene

1,3,5-TMB = 1,3,5-Trimethylbenzene

MTBE = Methyl Tert-Butyl Ether

NP = Analysis Not Performed

R/WIEN/AA5

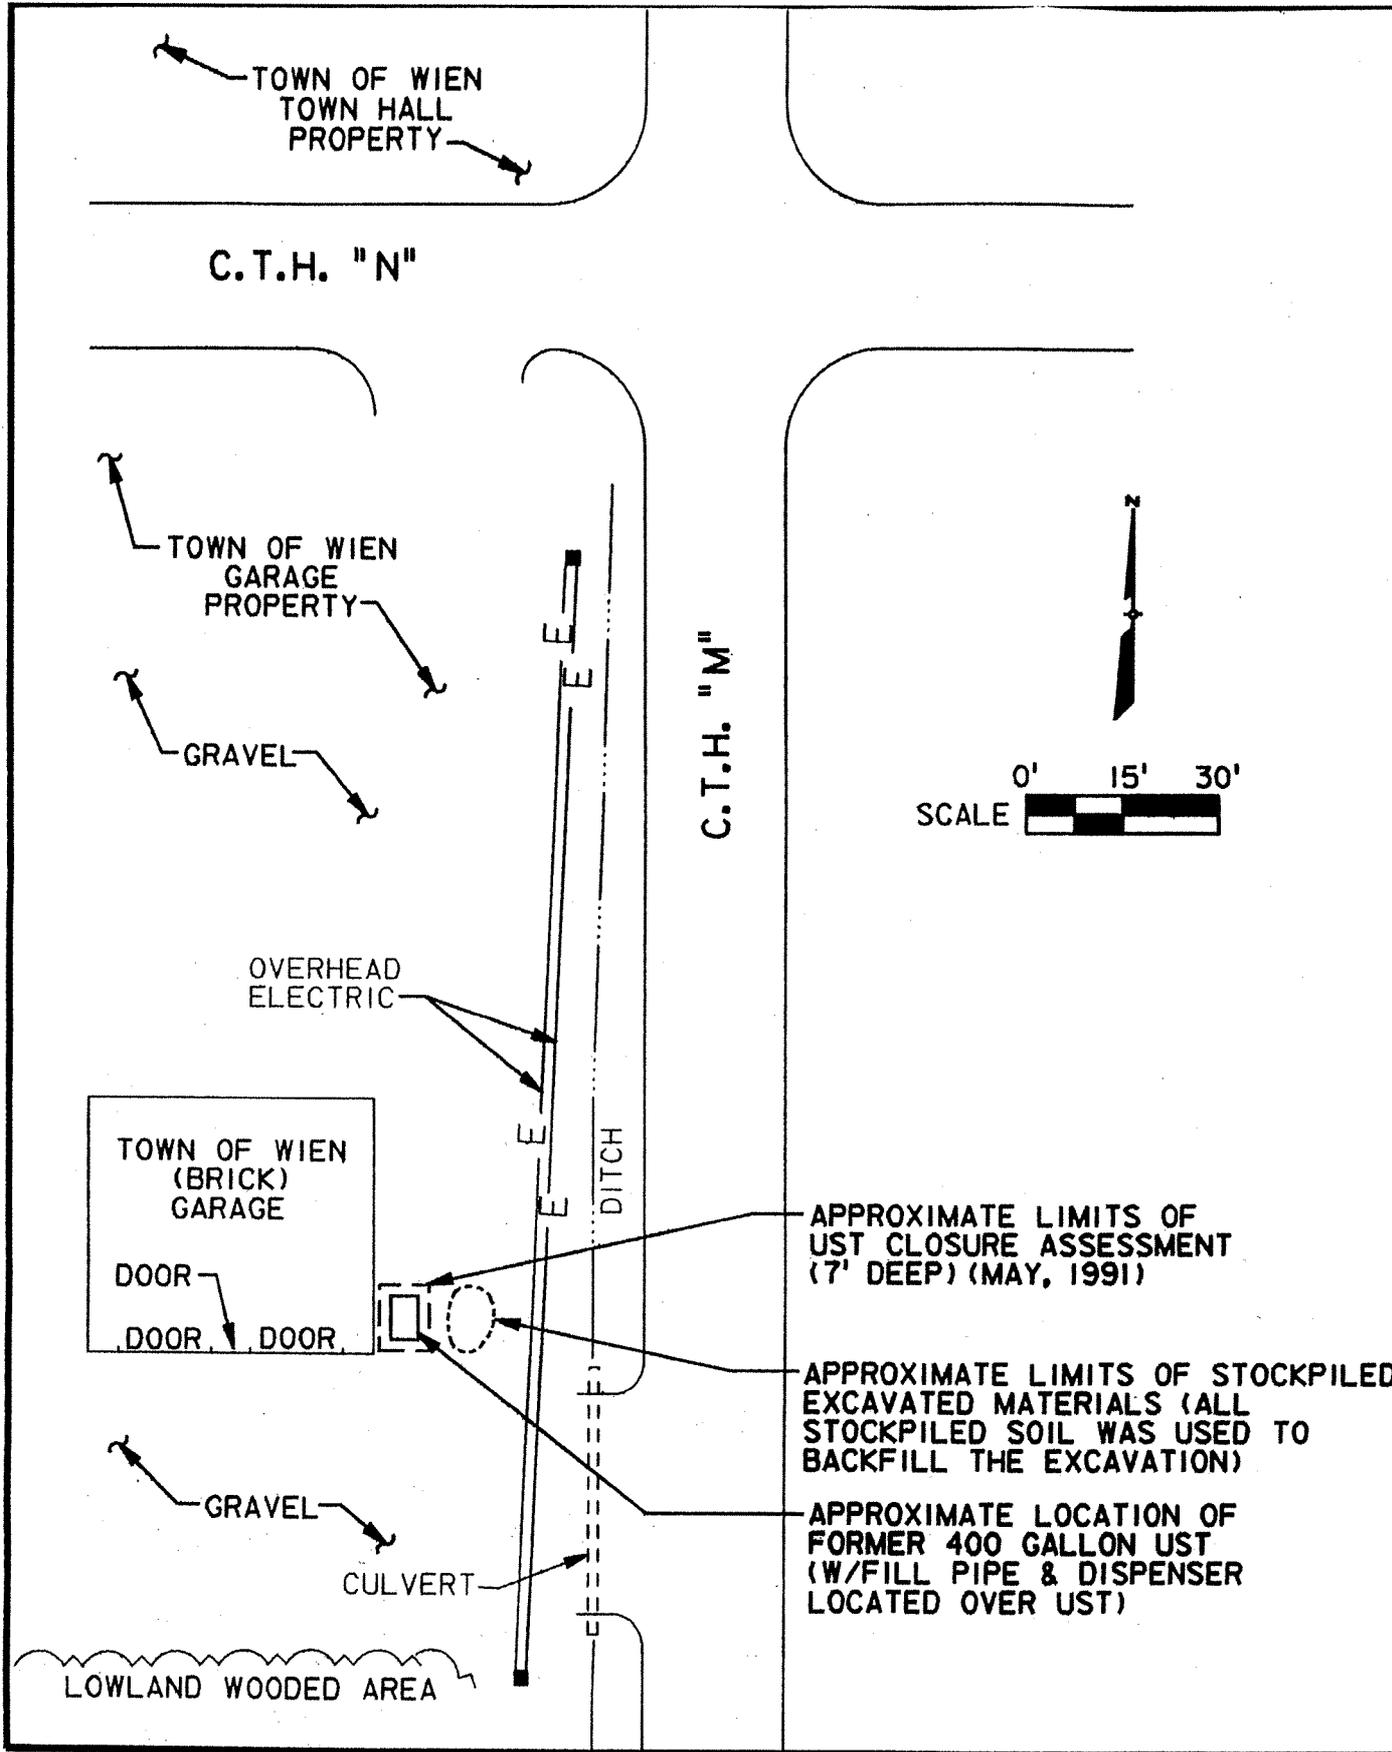


FIGURE 2-2
 SITE PLAN
 TOWNSHIP GARAGE
 TOWN OF WIEN
 MARATHON COUNTY, WISCONSIN

TABLE 1
WELL CONSTRUCTION DATA AND GROUNDWATER ELEVATIONS
FORMER UST SITE
TOWN OF WEIN GARAGE
MARATHON COUNTY, WISCONSIN

Well No.	Date Installed	Top of Casing Elevation (ft MSL)	Well Depth	Depth of Screened Interval (ft)	Date	Depth to Water (ft)	Groundwater Elevation (ft MSL)
MW-1	12/04/91	1,320.07	16	11.0 - 16.0	08/14/00	1.97	1,318.10
					08/17/00	1.61	1,318.46
					08/23/00	2.41	1,317.66
					09/01/00	3.13	1,316.94
					03/02/01	2.23	1,317.84
					08/29/01	2.10	1,317.97
					05/30/02	2.36	1,317.71
MW-2R	08/04/00	1,319.50	11.0	3.5 - 11.0	08/14/00	1.51	1,317.99
					08/17/00	1.16	1,318.34
					08/23/00	1.91	1,317.59
					09/01/00	2.70	1,316.80
					03/02/01	1.86	1,317.64
					08/29/01	1.72	1,317.78
					05/30/02	2.02	1,317.48
MW-3	08/04/00	1,323.43	11.0	3.5 - 11.0	08/14/00	5.53	1,317.90
					08/17/00	5.17	1,318.26
					08/23/00	6.05	1,317.38
					09/01/00	6.77	1,316.65
					03/02/01	5.96	1,317.47
					08/29/01	5.81	1,317.62
					05/30/02	6.14	1,317.29
MW-4	08/04/00	1,323.37	11.0	3.5 - 11.0	08/14/00	5.37	1,318.00
					08/17/00	5.02	1,318.35
					08/23/00	5.90	1,317.47
					09/01/00	6.58	1,316.79
					03/02/01	5.92	1,317.45
					08/29/01	5.76	1,317.61
					05/30/02	6.15	1,317.22


Notes:

1. Depth to water measured from top of casing.
2. Well depths and depths of screened intervals measured from ground surface.
3. Well MW-1 was installed as a piezometer.

\$\$\$REF03\$\$
\$\$\$RF03\$\$
\$\$\$REF04\$\$
\$\$\$RF04\$\$

\$\$\$REF01\$\$
\$\$\$RF01\$\$
\$\$\$REF02\$\$
\$\$\$RF02\$\$

\$\$\$USER\$\$
\$\$\$LEVELS\$\$
\$\$\$PRF\$\$
\$\$\$DATE\$\$

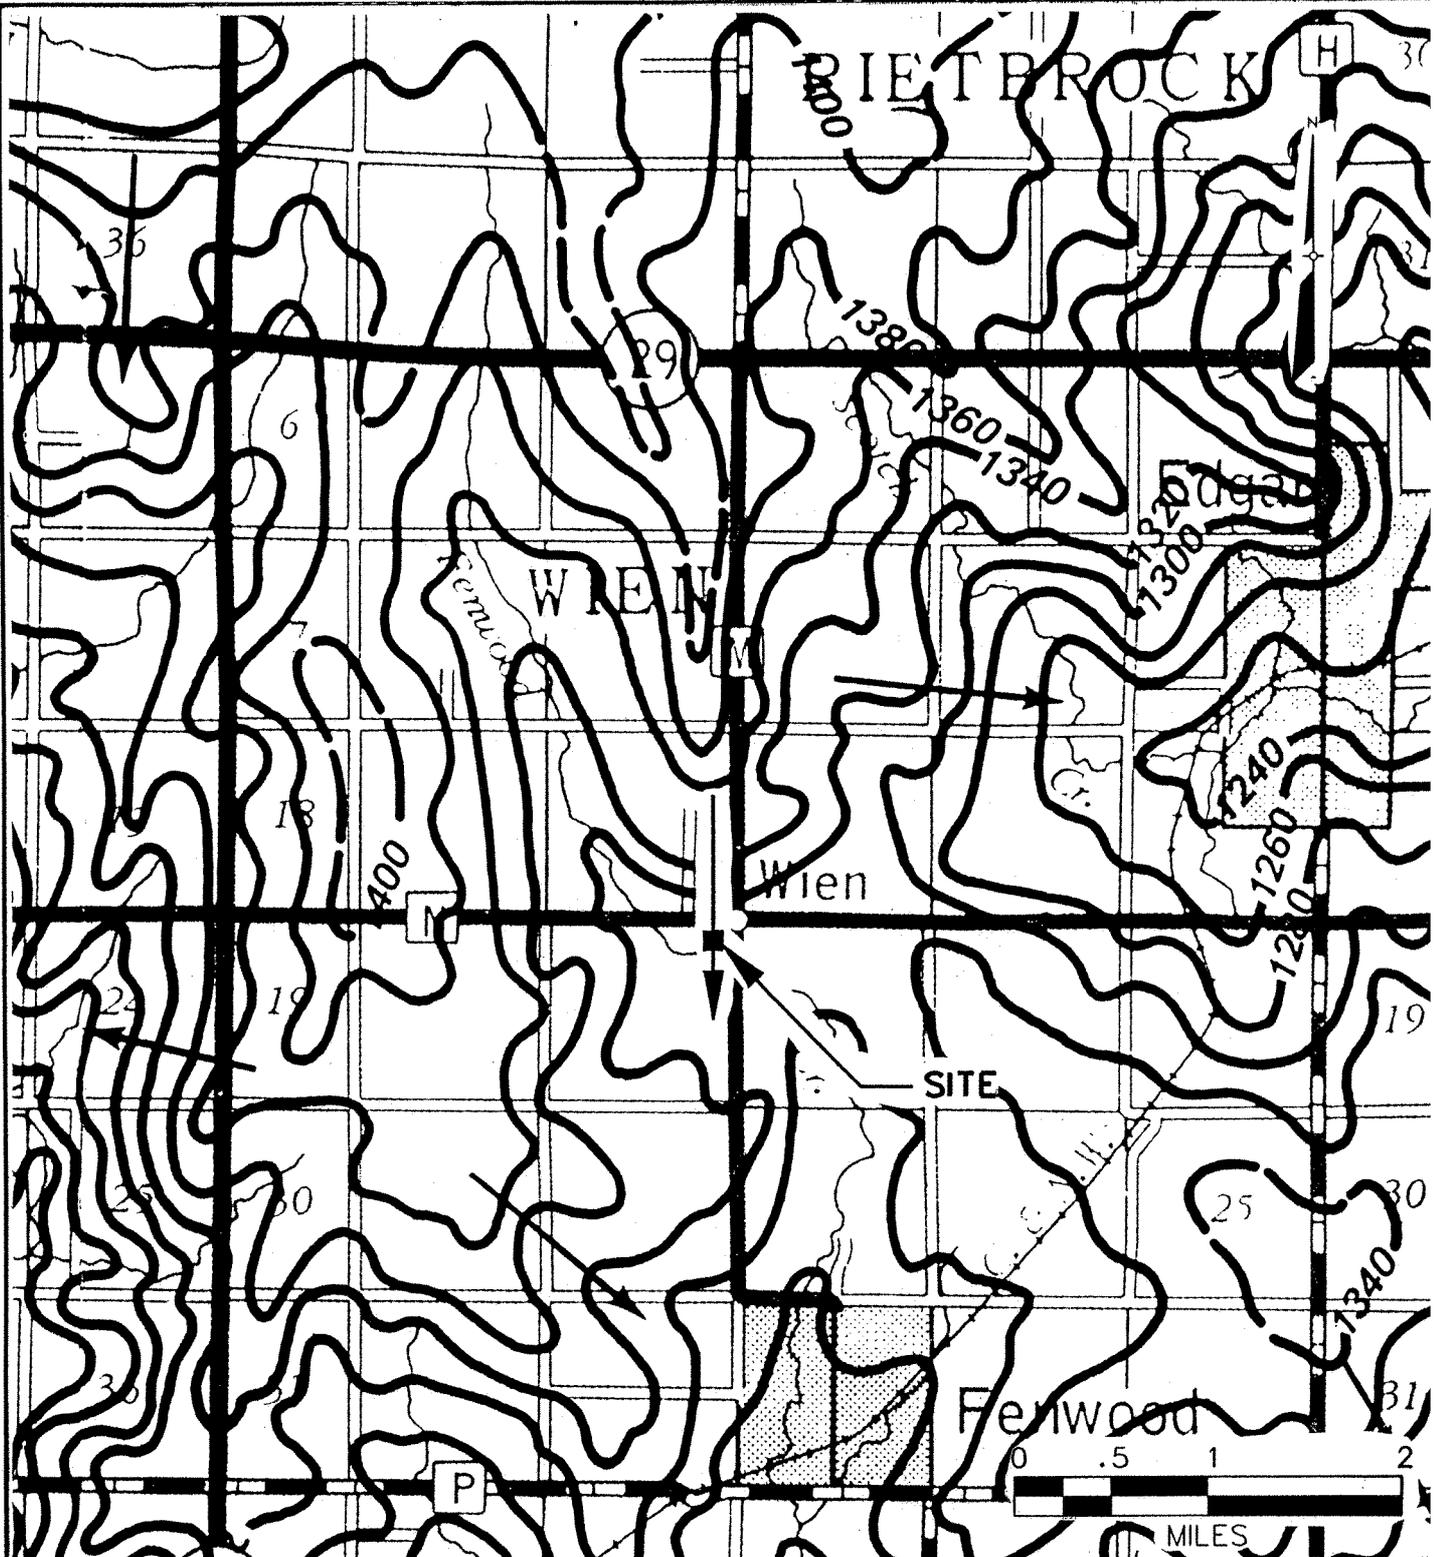

LEGEND

- 1320 — GROUNDWATER ELEVATION CONTOUR (FEET MSL)-DASHED WHERE APPROXIMATE
- APPARENT GROUNDWATER FLOW DIRECTION

SOURCE:
GROUNDWATER ELEVATION
CONTOURS FROM I.D. LIPPELT,
WISCONSIN GEOLOGICAL AND
NATURAL HISTORY SURVEY, 1981



FIGURE 3
REGIONAL GROUNDWATER MAP
FORMER UST SITE
TOWN OF WIEN GARAGE
MARATHON COUNTY, WISCONSIN

AUGUST 2002

41590

REFERENCE FILE 01 = L:\work\Projects\41590\gra\48511p.dgn
 Levels = 1-63
 REFERENCE FILE 02 = L:\work\Projects\41590\gra\site.dgn
 Levels = 1,2,4-63

User is TKuhn83072
 Levels are 1,2,4-63
 PRF = L:\work\Projects\41590\gra\FIG5.prf
 DATE=Thu Aug 1 09:37:50 2002

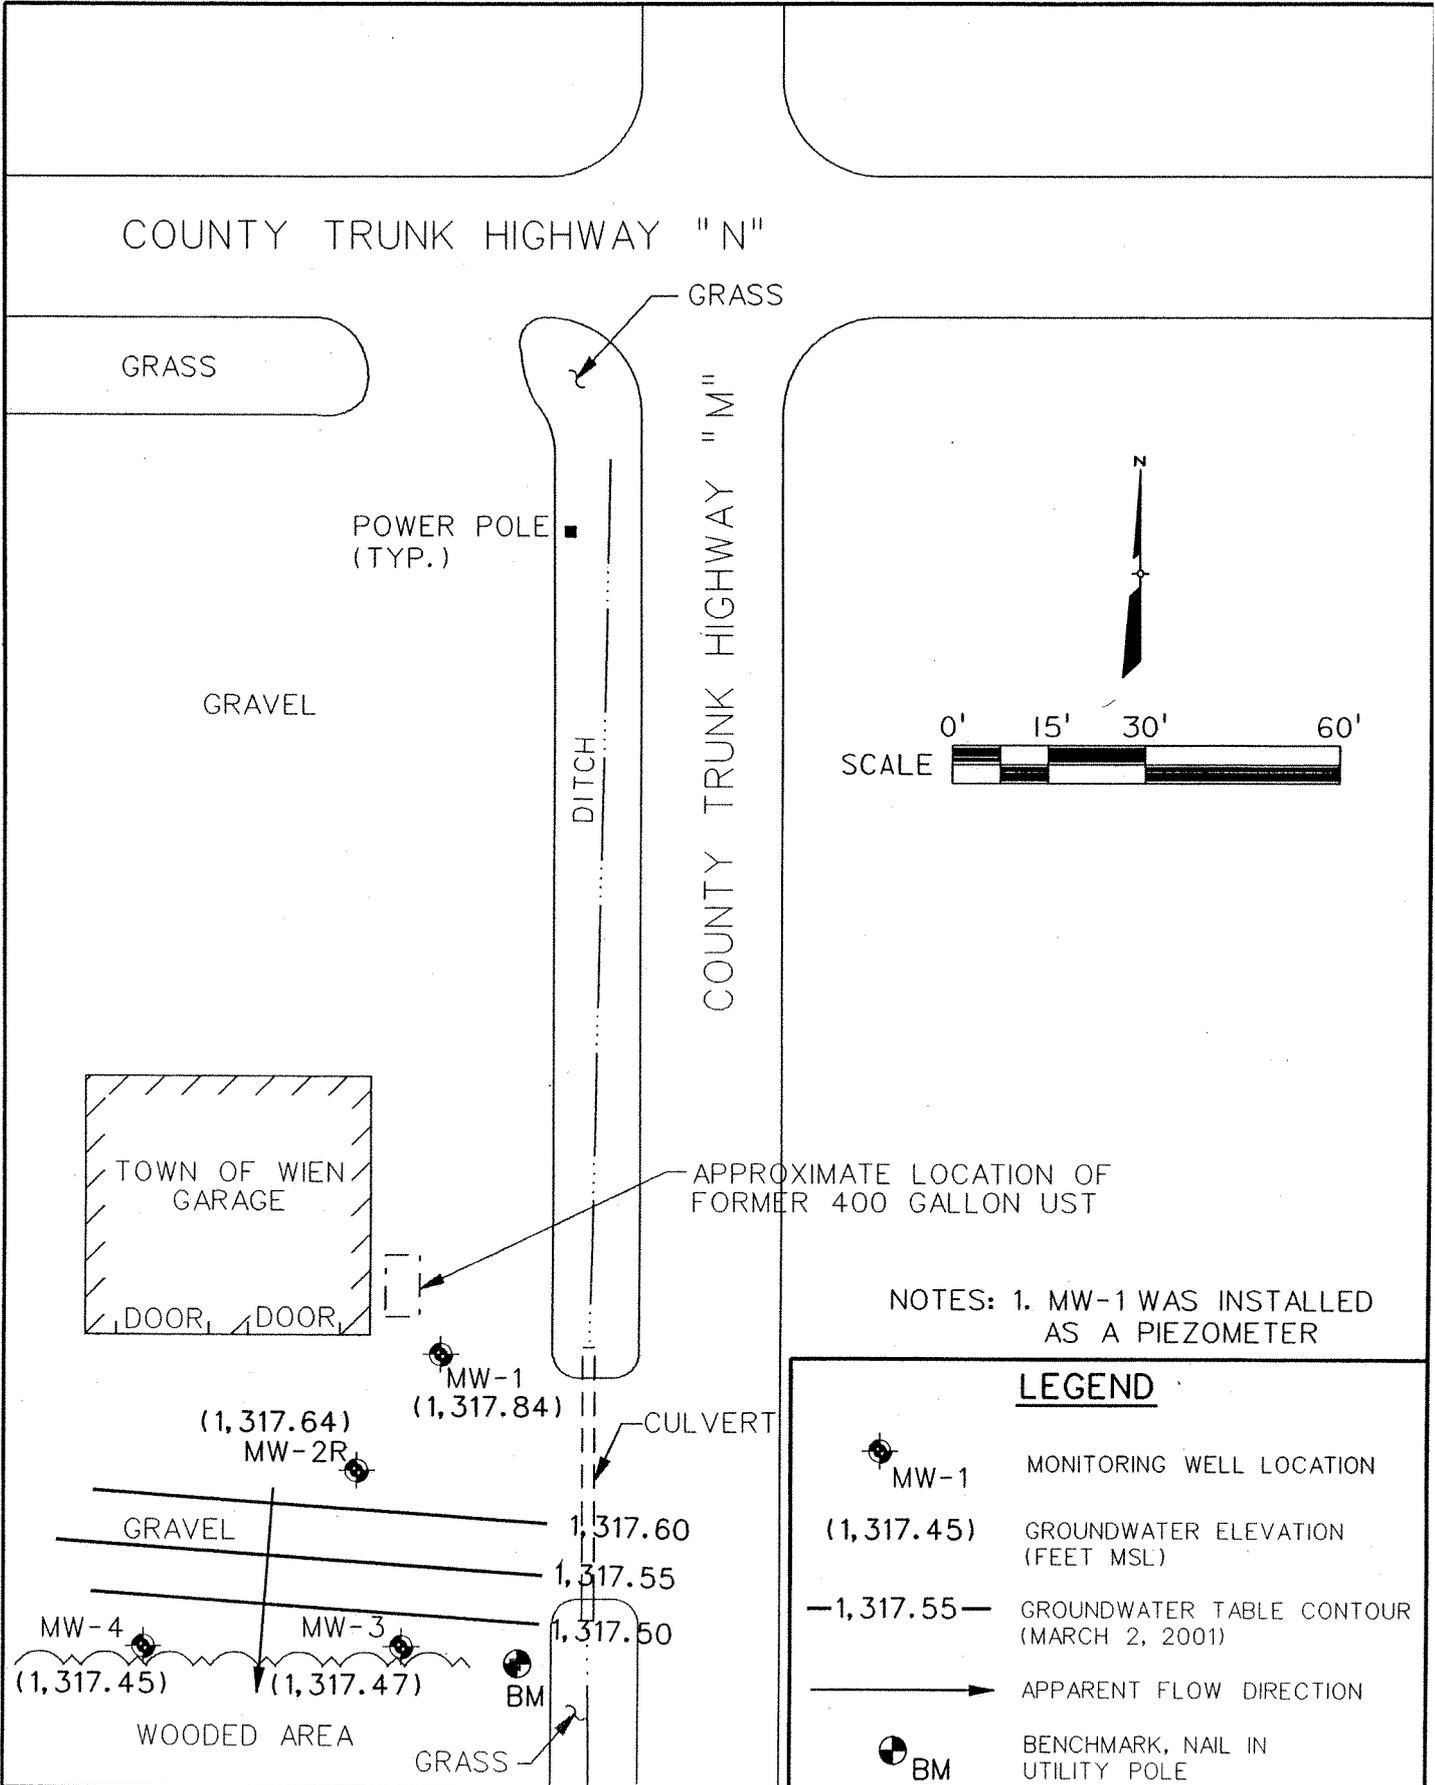


FIGURE 5
 SITE MAP
 FORMER UST SITE
 TOWN OF WIEN GARAGE
 MARATHON COUNTY, WISCONSIN

AUGUST 2002

41590

REFERENCE FILE 01 = L:\work\Projects\41590\gra\851fp.dgn
 Levels = 1-63
 REFERENCE FILE 02 = L:\work\Projects\41590\gra\site.dgn
 Levels = 1,2,4-63

User is TKuhn83072
 Levels are 1,2,4-63
 PRF = L:\work\Projects\41590\gra\Fig6.prf
 DATE=Thu Aug 1 09:37:51 2002

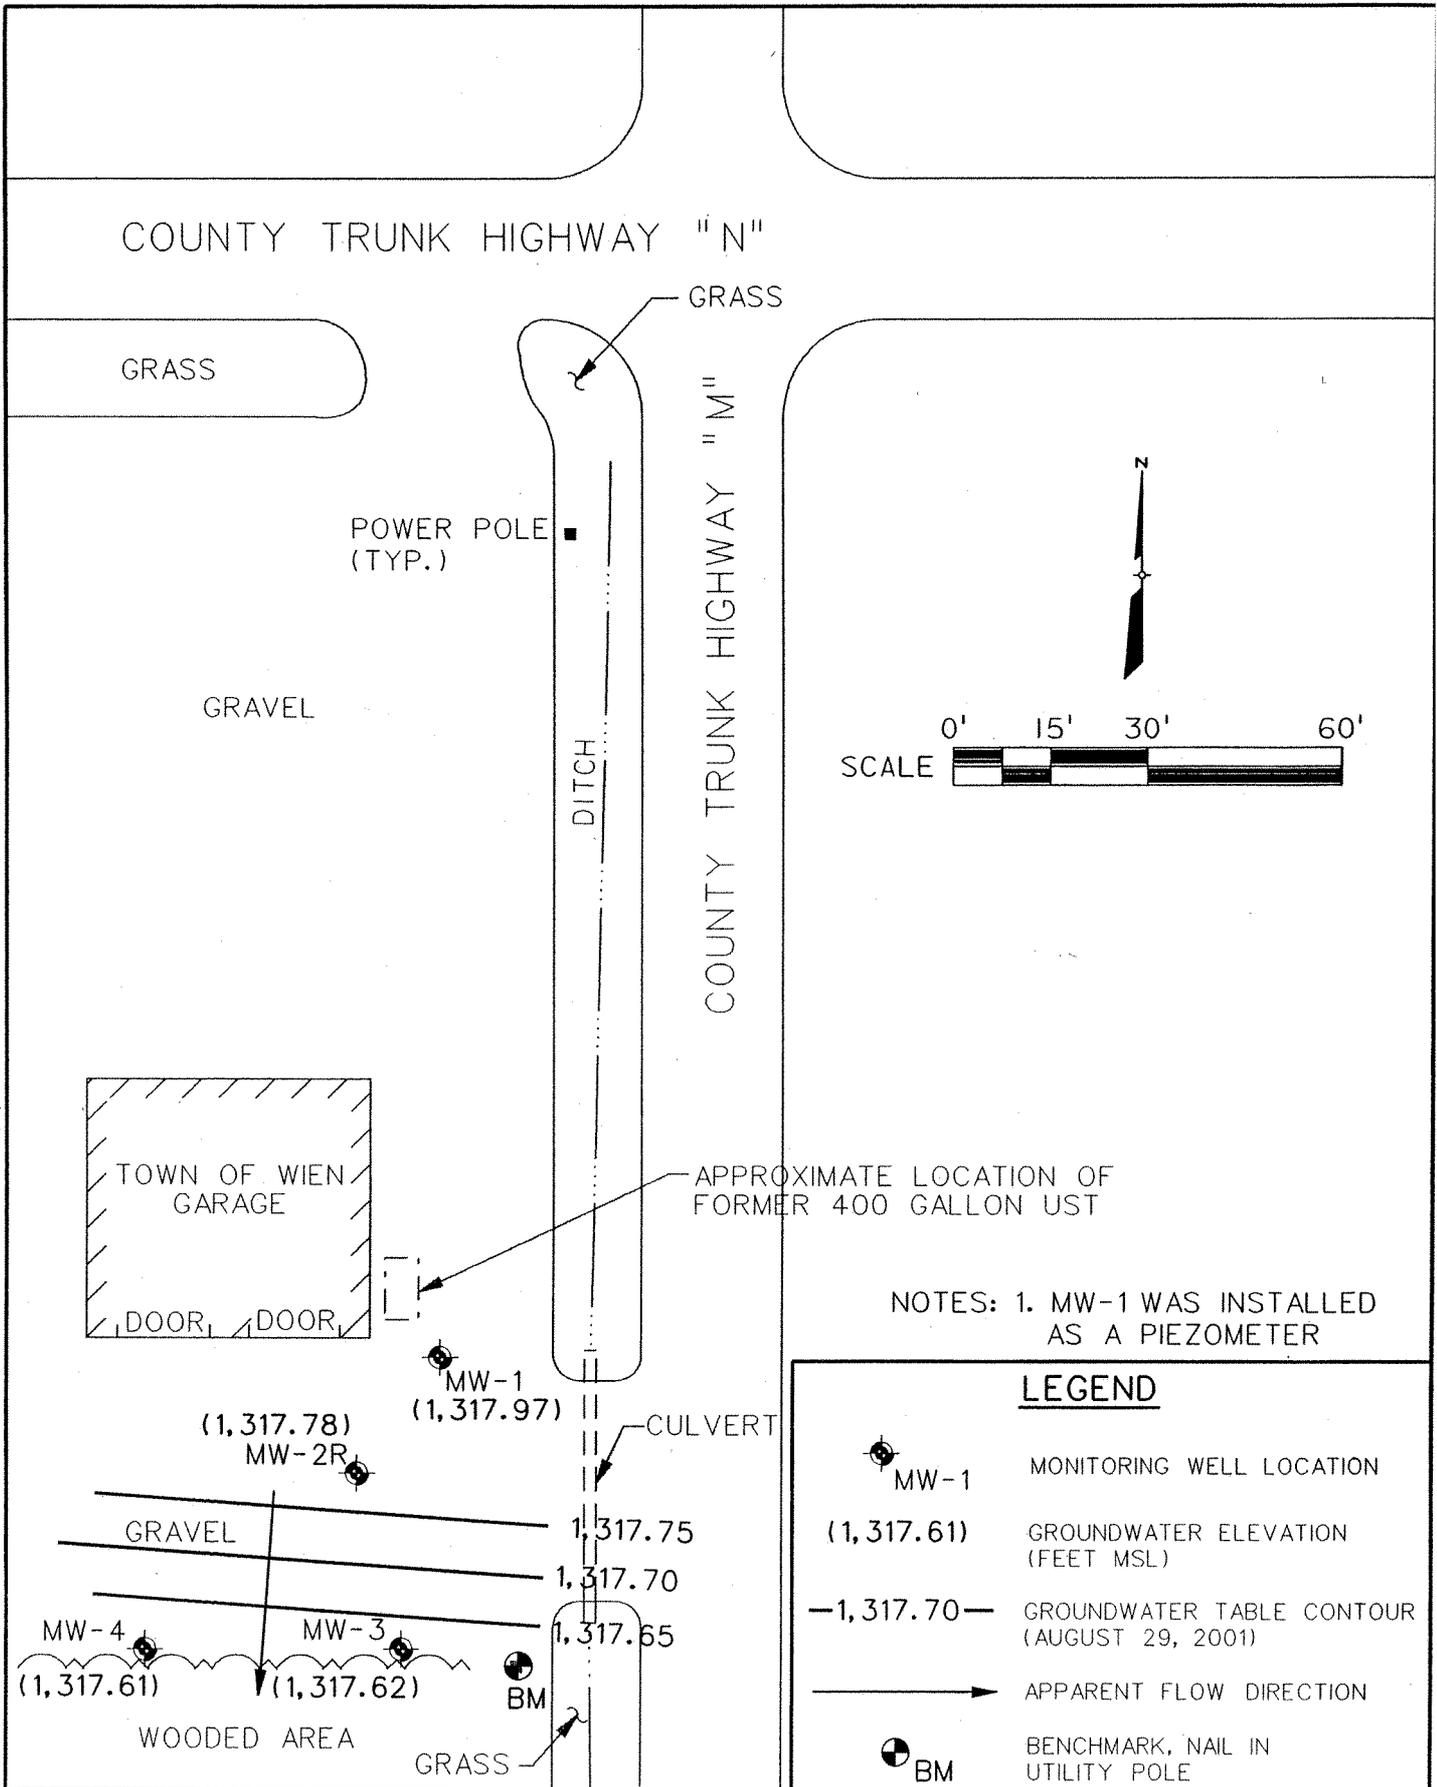



FIGURE 6
SITE MAP
FORMER UST SITE
TOWN OF WIEN GARAGE
MARATHON COUNTY, WISCONSIN

AUGUST 2002

41590

REFERENCE FILE_01 = L:\work\Projects\41590\gra\8511p.dgn
 Levels = 1-63
 REFERENCE FILE_02 = L:\work\Projects\41590\gra\site.dgn
 Levels = 1,2,4-63

User is TKuhn83072
 Levels are 1,2,4-63
 PRF = L:\work\Projects\41590\gra\FIG7.prf
 DATE=Thu Aug 1 09:37:53 2002

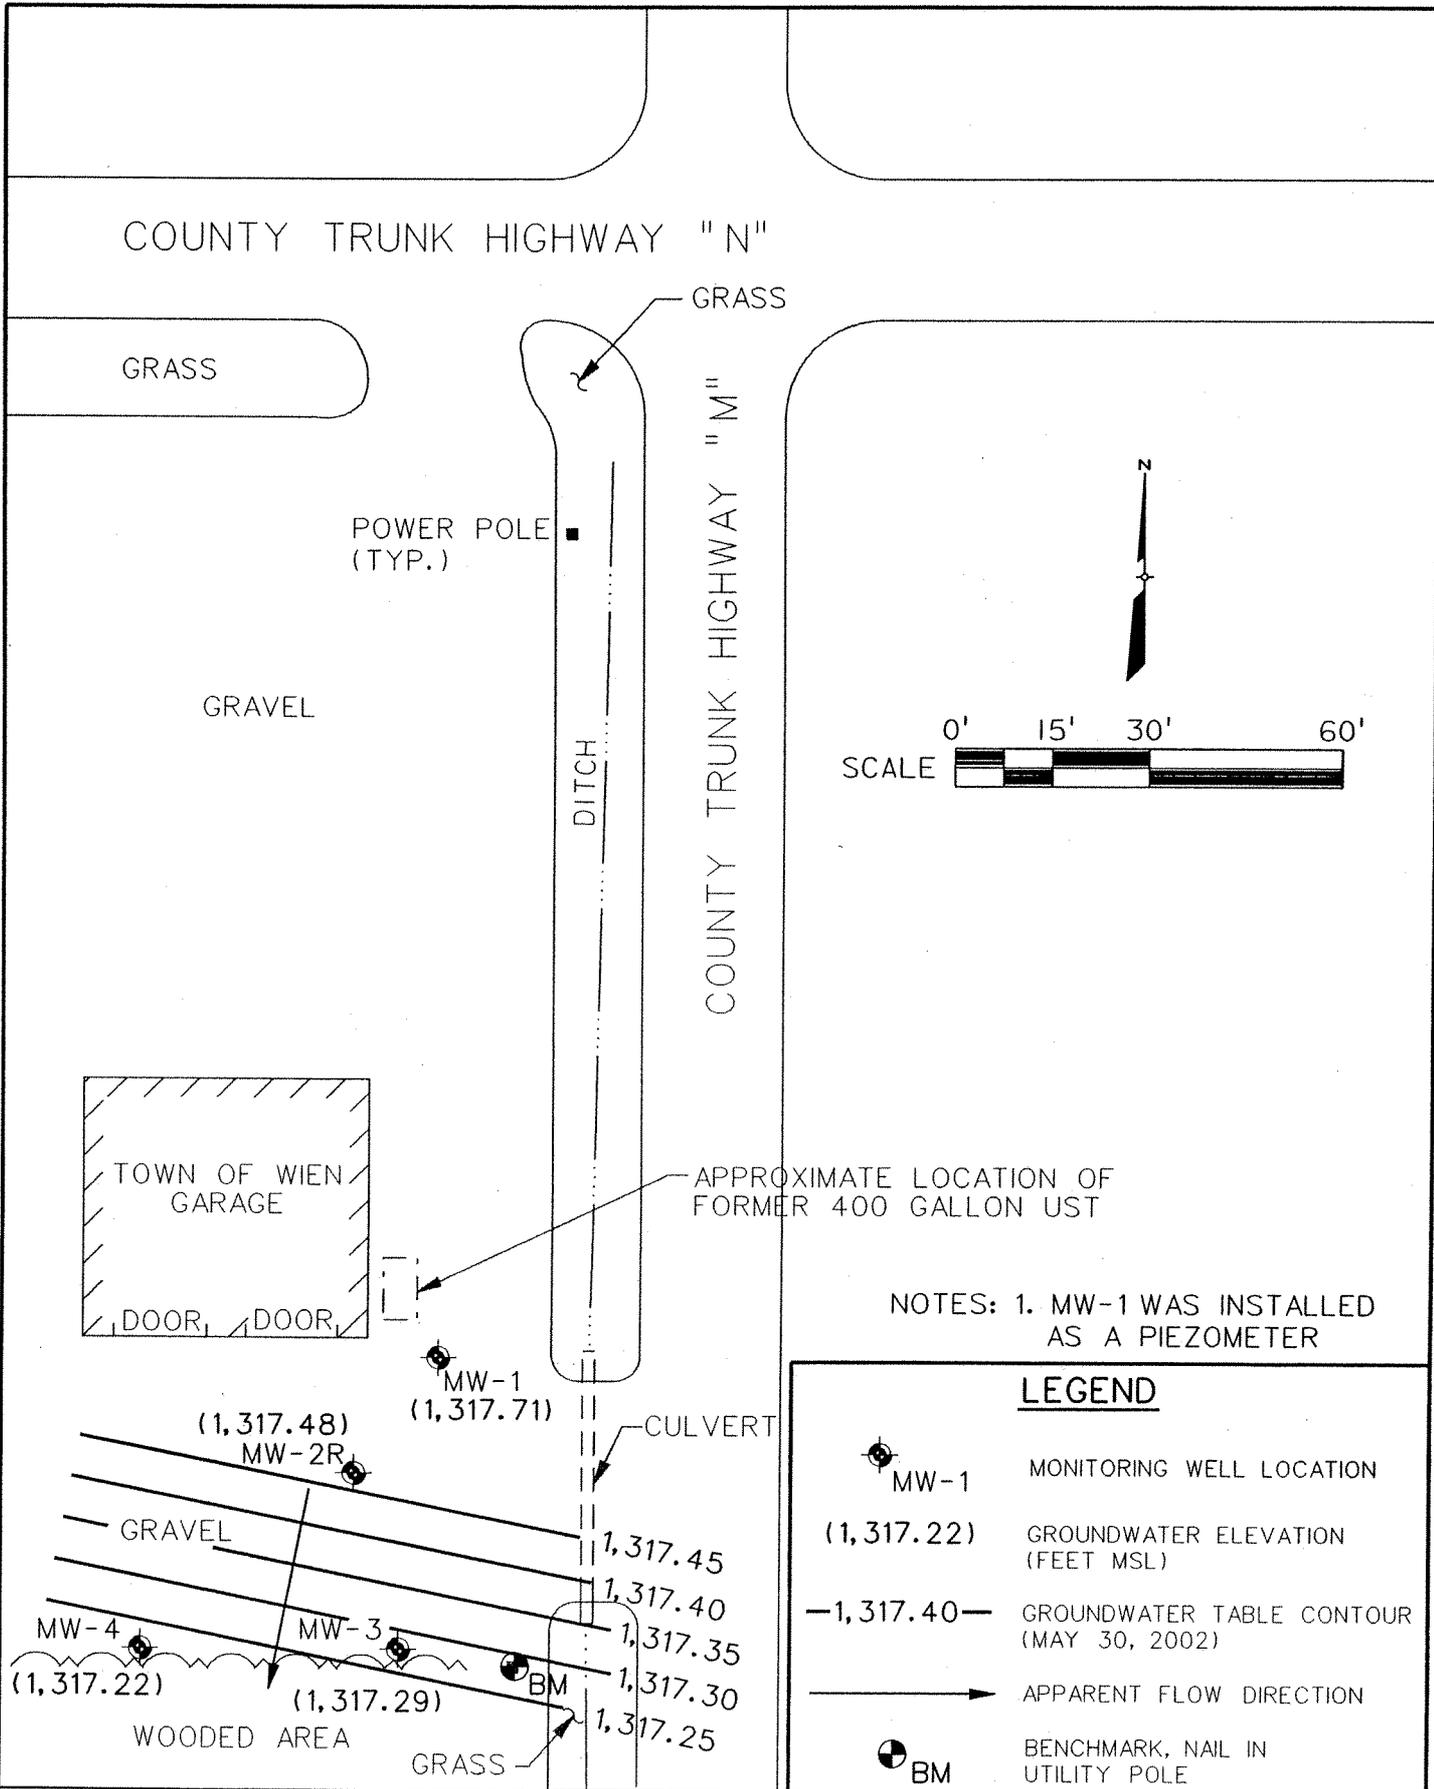

NOTES: 1. MW-1 WAS INSTALLED AS A PIEZOMETER

LEGEND

- MW-1 MONITORING WELL LOCATION
- (1,317.22) GROUNDWATER ELEVATION (FEET MSL)
- 1,317.40- GROUNDWATER TABLE CONTOUR (MAY 30, 2002)
- APPARENT FLOW DIRECTION
- BM BENCHMARK, NAIL IN UTILITY POLE



FIGURE 7
 SITE MAP
 FORMER UST SITE
 TOWN OF WIEN GARAGE
 MARATHON COUNTY, WISCONSIN

AUGUST 2002

41590




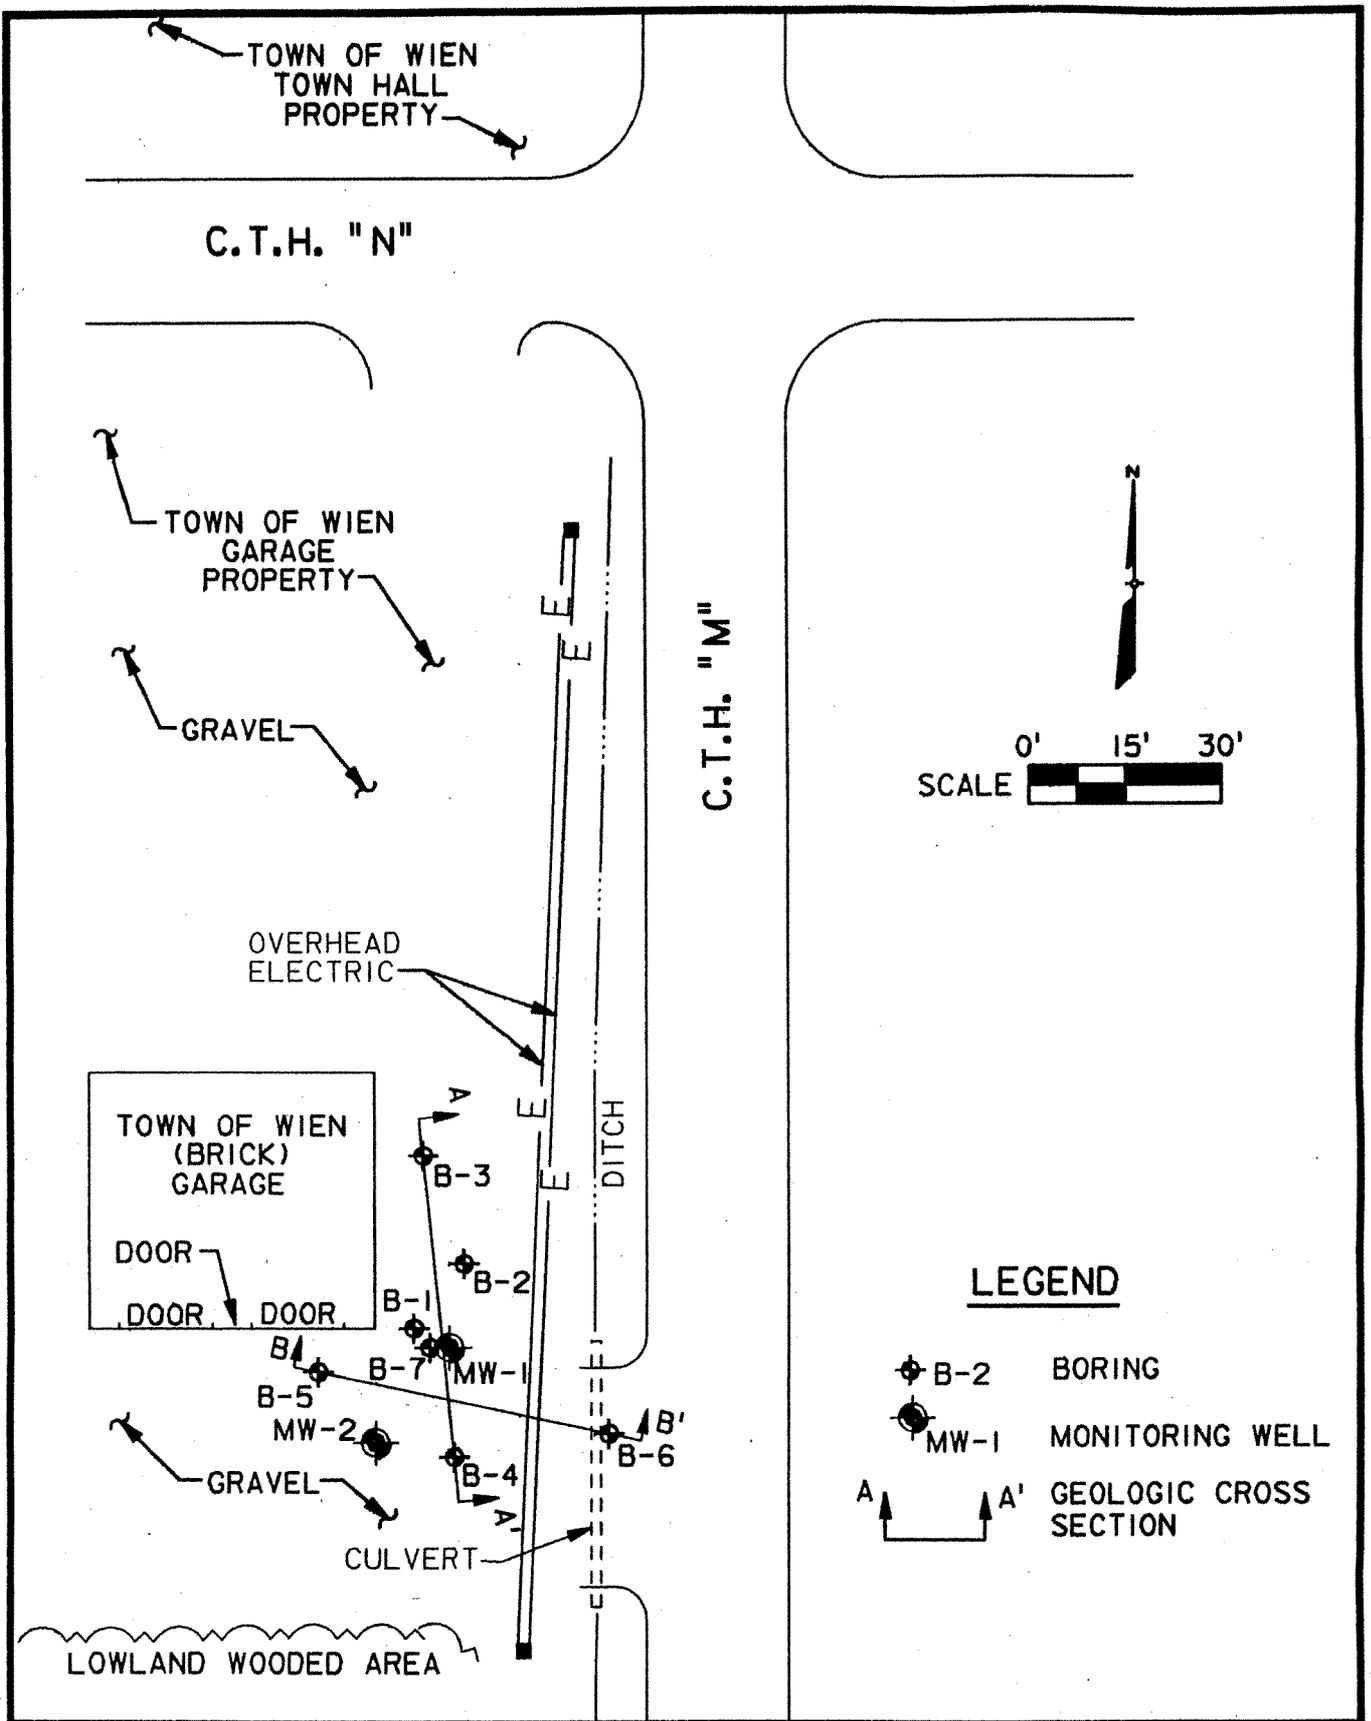


FIGURE 3-1
SOIL BORINGS & MONITORING WELLS
TOWNSHIP GARAGE
TOWN OF WIEN
MARATHON COUNTY, WISCONSIN

Donohue ENGINEERS
 ARCHITECTS
 SCIENTISTS

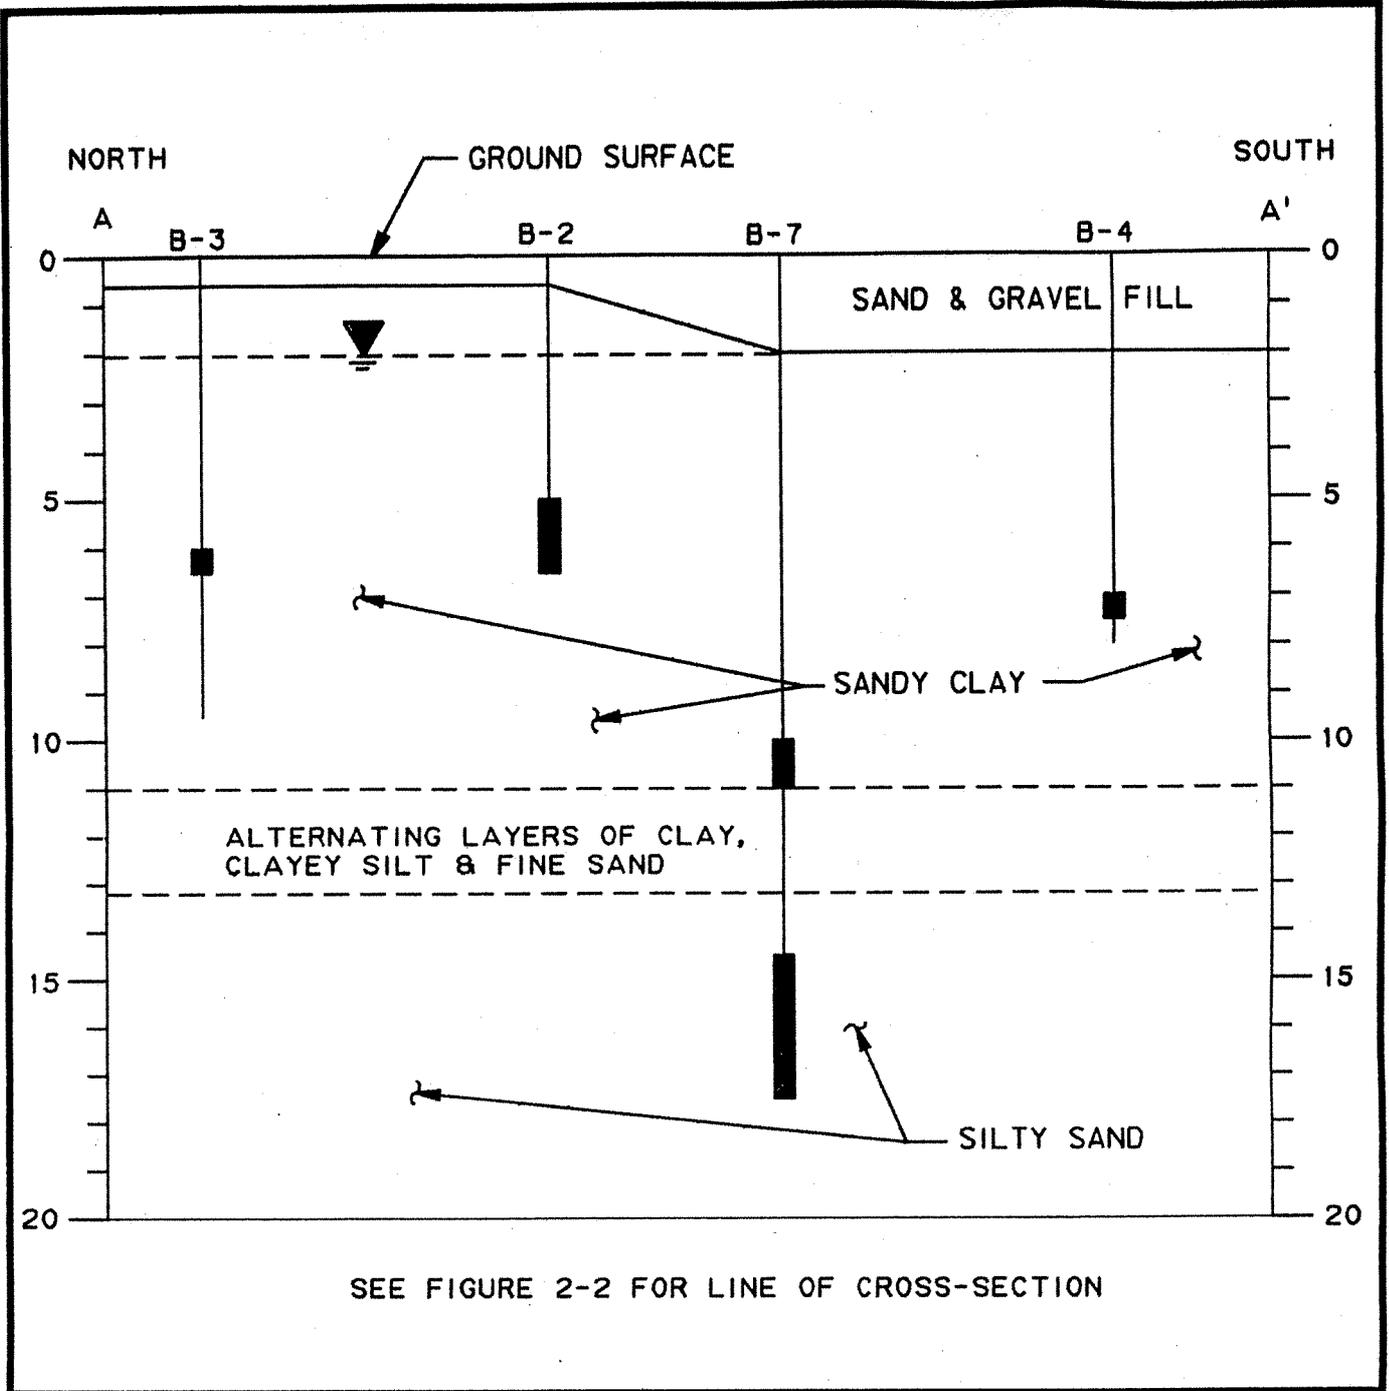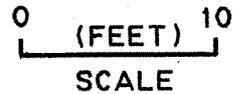


LEGEND

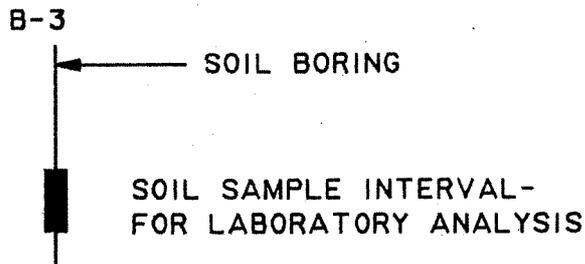

APPROXIMATE WATER TABLE

FIGURE 4-1
GEOLOGICAL CROSS-SECTION A-A'
TOWNSHIP GARAGE
TOWN OF WIEN
MARATHON COUNTY, WISCONSIN

Donohue ENGINEERS
 ARCHITECTS
 SCIENTISTS

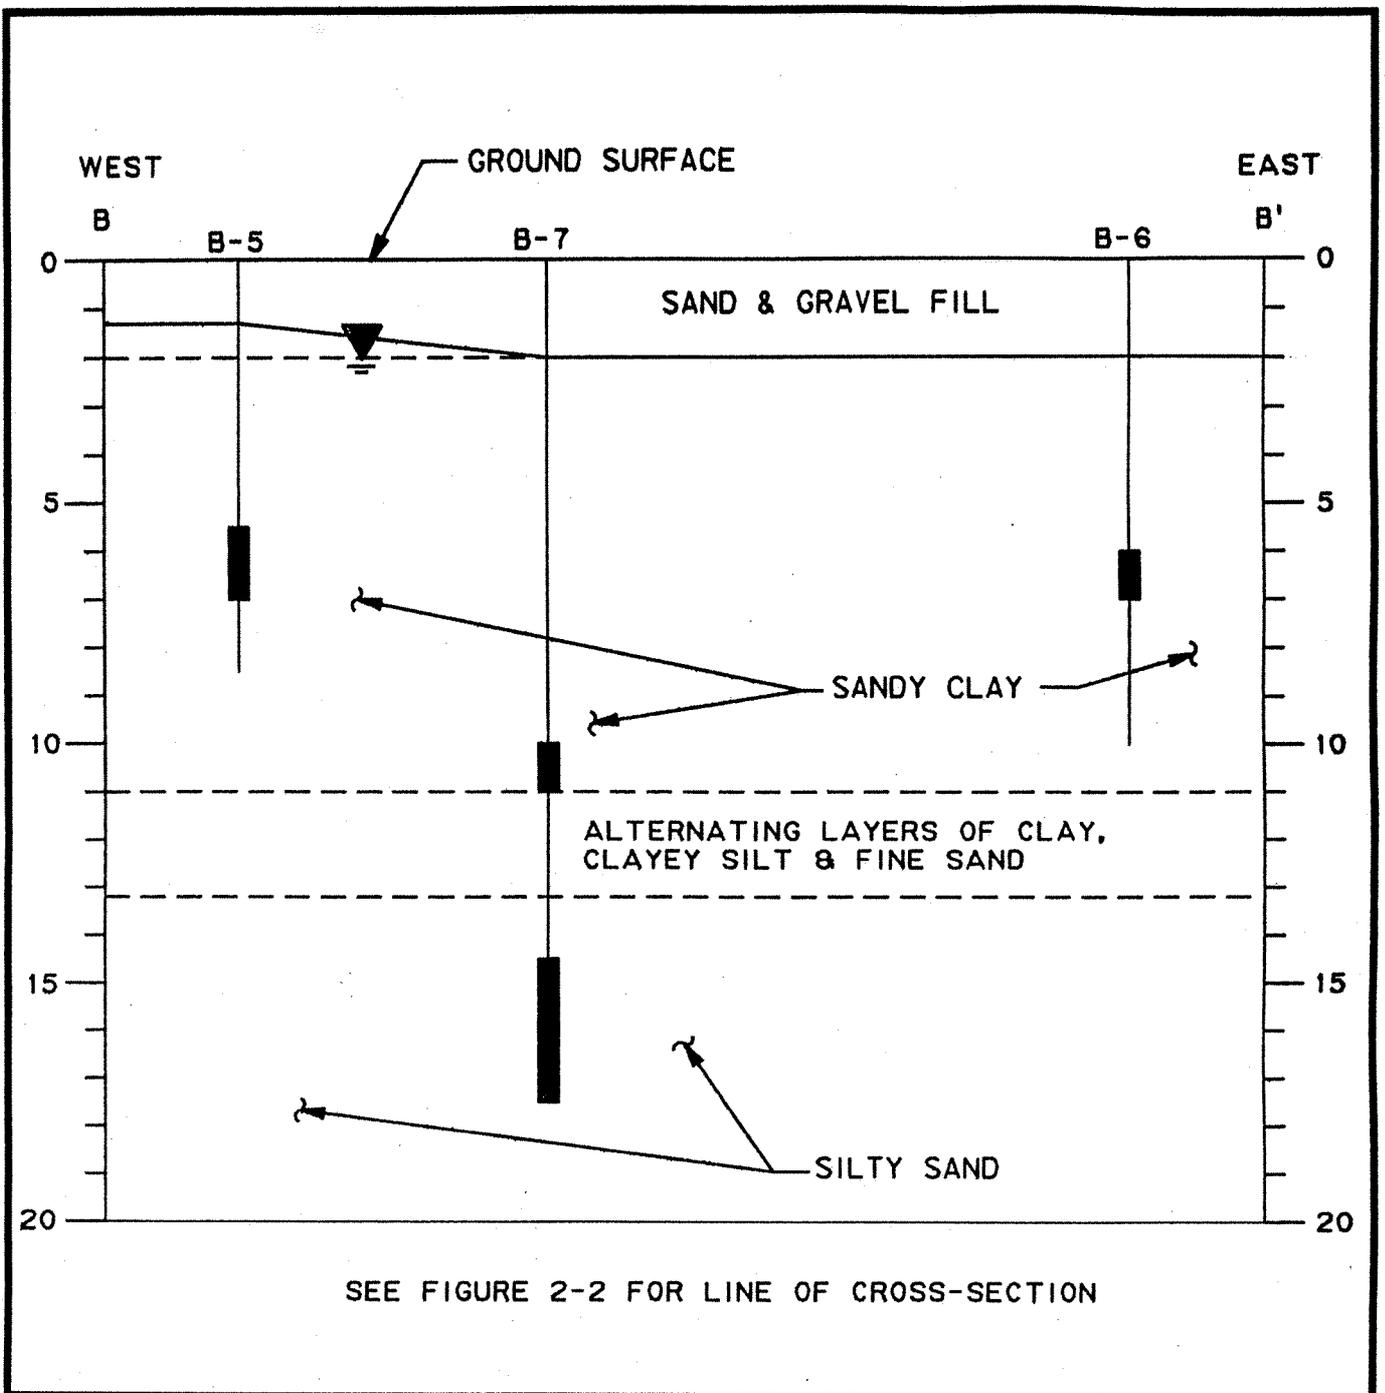

LEGEND

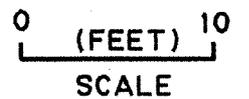
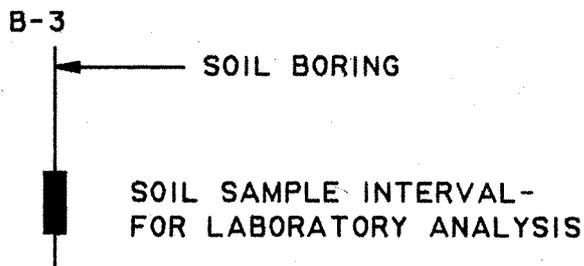


FIGURE 4-2
GEOLOGICAL CROSS-SECTION B-B'
TOWNSHIP GARAGE
TOWN OF WIEN
MARATHON COUNTY, WISCONSIN

Donohue ENGINEERS
 ARCHITECTS
 SCIENTISTS

6-27-03

To Whom It May Concern:

I Lowell Borchardt, CHAIRMAN, TOWN OF WIEN, do hereby state that it is my belief, that all legal descriptions attached to this statement are complete and accurate.

Lowell Borchardt
CHAIRMAN, TOWN OF WIEN
LOWELL BORCHARDT
W4311 WIEN DRIVE
EDGAR, WIS. 54426